

WATER SERVICE RECORD

Name

Service No.

Address 18 Cary Ave

Location


Repair—Renewal—New Service

Date	Material	Amount	Total	Date	Material	Amount
4-17-63	Inside				Outside	
	39' 3/4" Copper			10-10-96	30'-1" Copper	
	1 3/4" c. X 1/2" l. w. H.	STOP	Waste		1-1" Corp	
					1-1" Curb	
					1-1 x 3/4 Adapt	
					1- Box	

DATE _____

TOWN OF LEXINGTON — BOARD OF PUBLIC WORKS
WATER DIVISION

Sketch of Service Here

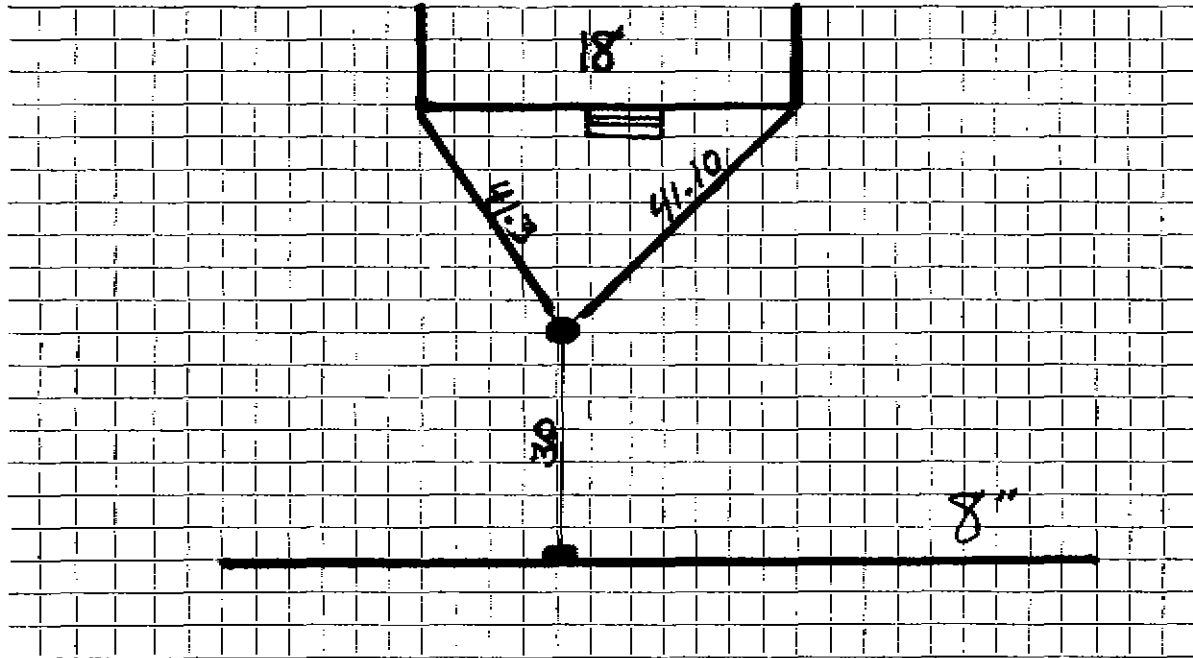

Connection made in Street. Work completed 10:10:96

Remarks:
.....
.....