

WATER SERVICE RECORD

Name

Service No.

Address *22 Cary Ave*

Location


Repair—Renewal—New Service

| Date | Material | Amount | Total | Date | Material | Amount |
|---------|-------------------------------|--------|-------|---------|-----------------------------|--------|
| 9-19-74 | Inside | | | | Outside: | |
| | 52' $\frac{3}{4}$ " Copper | | | 9-26-76 | 27'-1" Copper | |
| | 1 $\frac{3}{4}$ " Wheel Valve | | | | 1-1" Corp | |
| | 1 $\frac{3}{4}$ " Br. Elbow | | | | 1-1" Curb | |
| | | | | | 1- Box | |
| | | | | | 1- 1x $\frac{3}{4}$ Adap T. | |

DATE _____

TOWN OF LEXINGTON — BOARD OF PUBLIC WORKS
WATER DIVISION

Sketch of Service Here

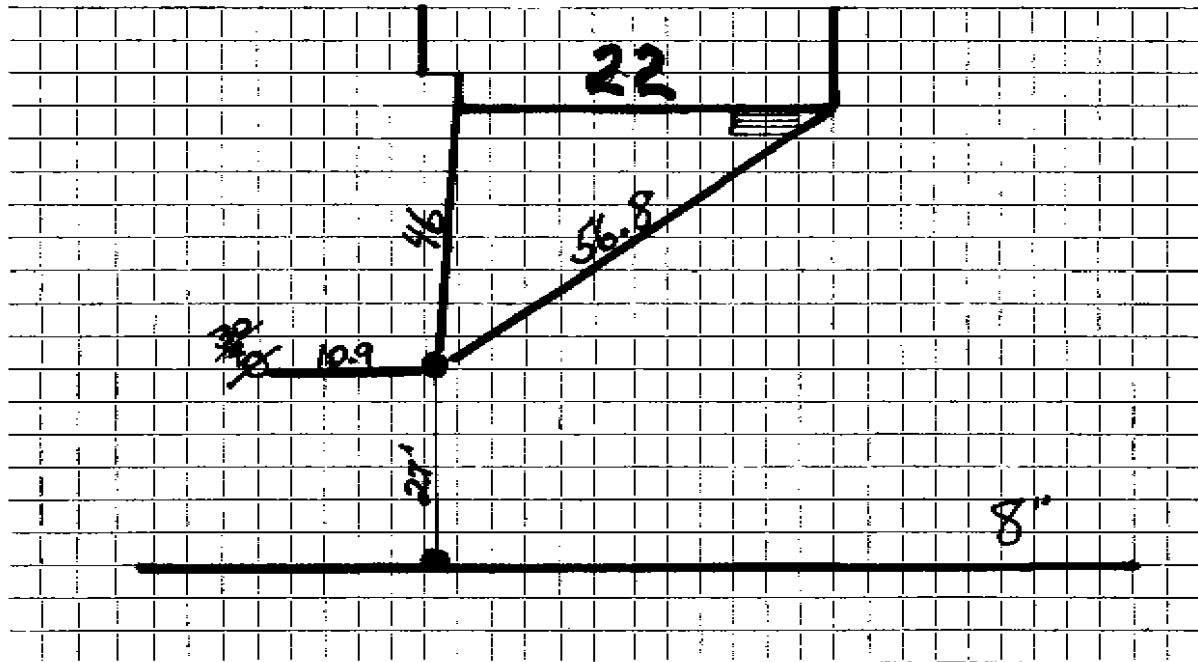

Connection made in Street. Work completed 9.26.96

Remarks:

.....

.....