

WATER SERVICE RECORD

Name

Service No.

Address 23 Cary Ave

Location


Repair—Renewal—New Service

Date	Material	Amount	Total	Date	Amount
6-14-56	Inside				Outside:
.	40' $\frac{3}{4}$ " Copper			9-3-96	12'-1" Copper
	1 $\frac{3}{4}$ " C. X $\frac{1}{2}$ " I.W.H.	STop	+ Waste		1-1" Corp.
					1-1" Curb.
					1- Box
					1- 1x $\frac{3}{4}$ Cop. Adapt.

DATE 11-8-96

TOWN OF LEXINGTON — BOARD OF PUBLIC WORKS
WATER DIVISION

Sketch of Service Here

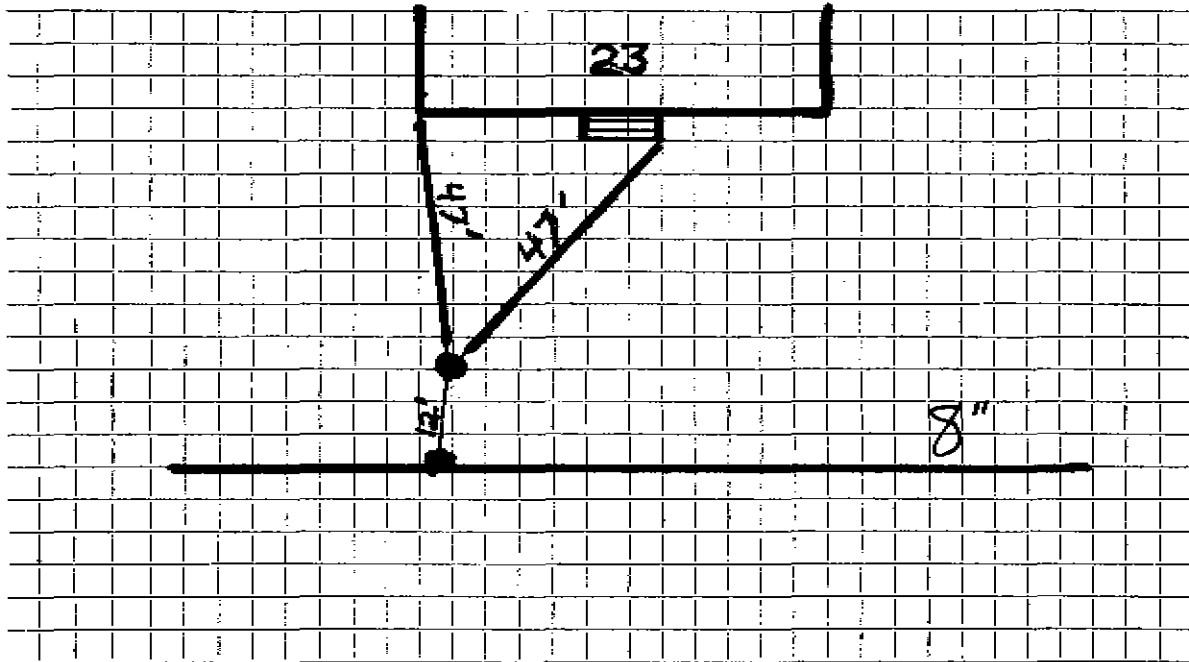

Connection made in Street. Work completed 9-3-96

Remarks: 7'-1" Cop. Inside Curb