

WATER SERVICE RECORD

Name

Service No.

Address

26 Cary Ave

Location


Repair—Renewal—New Service

Date	Material	Amount	Total	Date	Amount
8-5-72	Inside				Outside:
	48' 3/4" Copper			9-26-96	27'-1" Copper
	1 3/4" X 3/4"	Stop & Waste			1-1" Corp.
					1-1" Curb.
					1- Box
					1- 1x3/4 Adapt.

DATE \_\_\_\_\_

TOWN OF LEXINGTON — BOARD OF PUBLIC WORKS  
**WATER DIVISION**

Sketch of Service Here

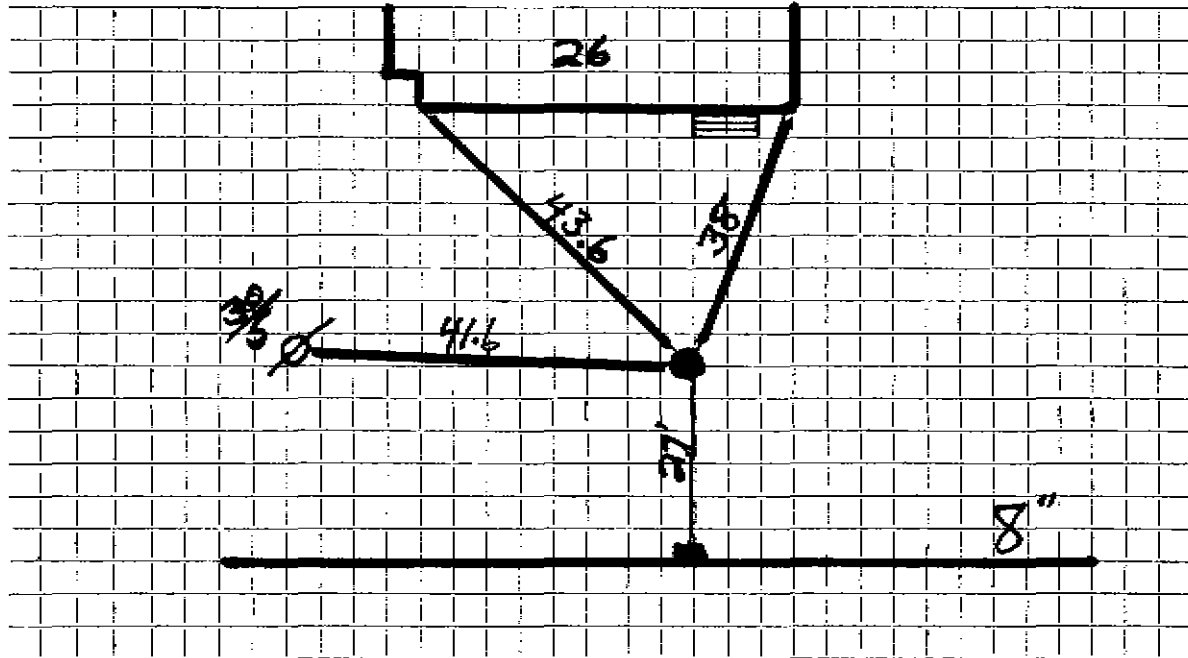

Connection made in ..... Street. Work completed 9.26.96 .....

Remarks: .....  
.....  
.....