

WATER SERVICE RECORD

Name

Service No.

Address 30 Cary Ave

Location


Repair—Renewal—New Service

Date	Material	Amount	Total	Date		Amount
8-30-51	Inside				Outside	
50'	3/4" Copper			9-25-96	26'-1" Copper	
	1 3/4" C. X 1/2" I.W. H.				1-1" Corp.	
	STOP + Waste				1-1" Curb.	
					1- Box	
					1-1 X 3/4 Adapt.	

DATE _____

TOWN OF LEXINGTON — BOARD OF PUBLIC WORKS
WATER DIVISION

Sketch of Service Here

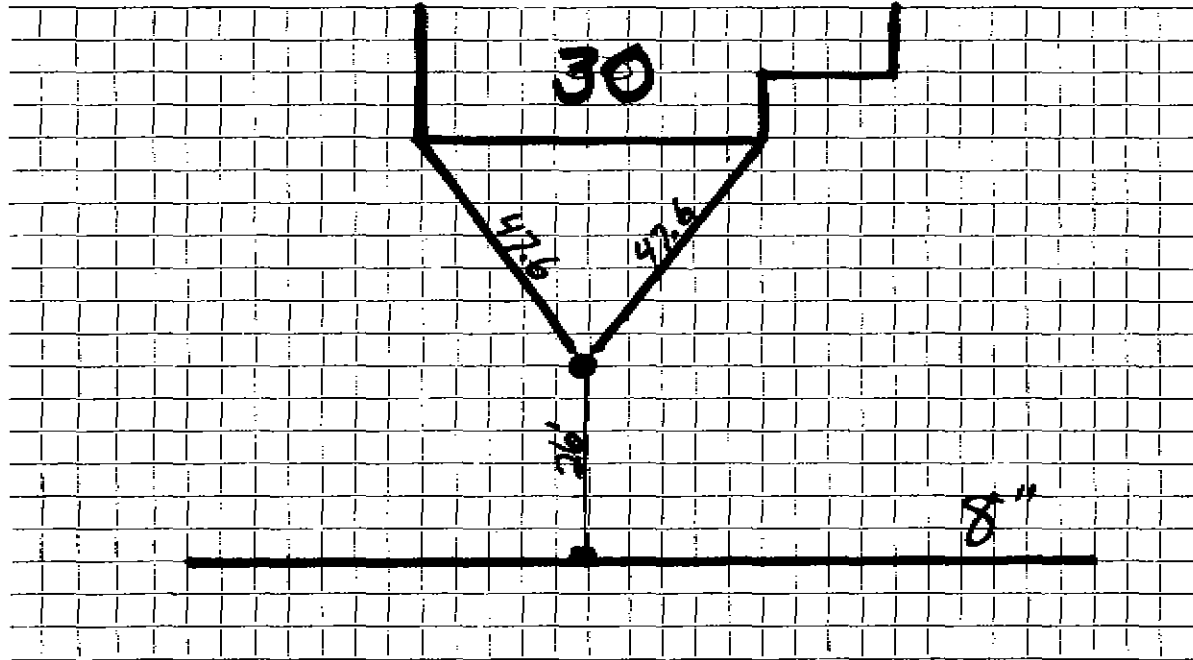

Connection made in Street. Work completed ... 9-25-96

Remarks:
.....
.....