


DATE _____

TOWN OF LEXINGTON — BOARD OF PUBLIC WORKS
WATER DIVISION

Sketch of Service Here
31 CARY AVE

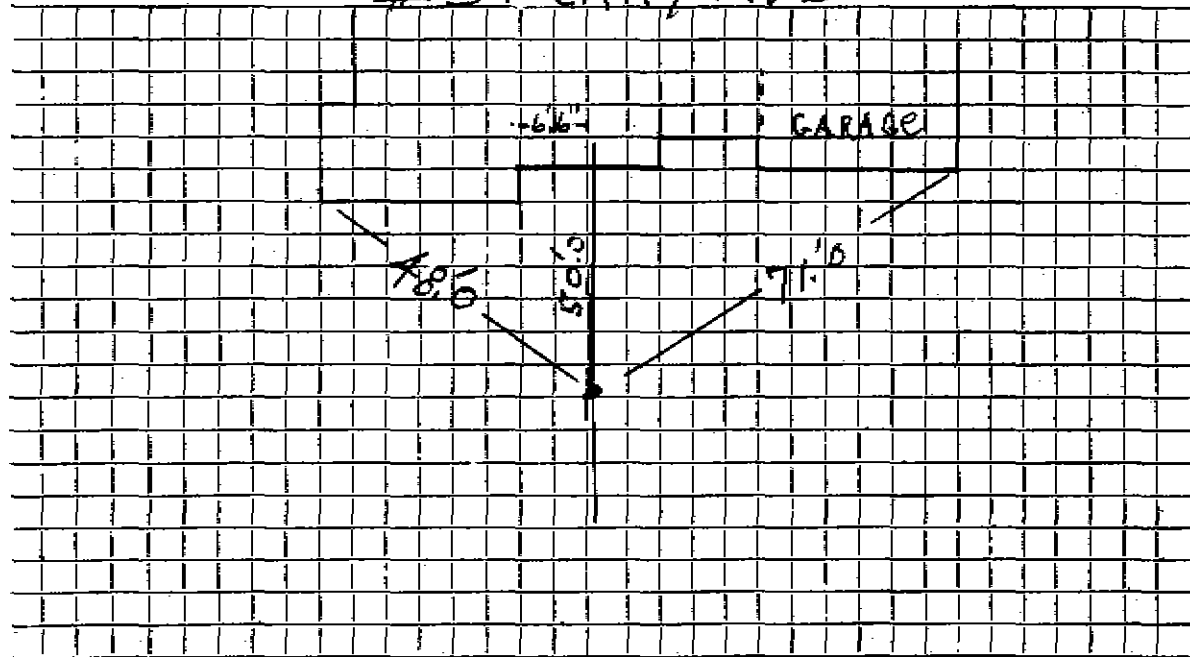

Connection made in Street. Work completed 2/8/06 J. McLaughlin

Remarks:
.....
.....