


DATE _____

TOWN OF LEXINGTON — BOARD OF PUBLIC WORKS

WATER DIVISION

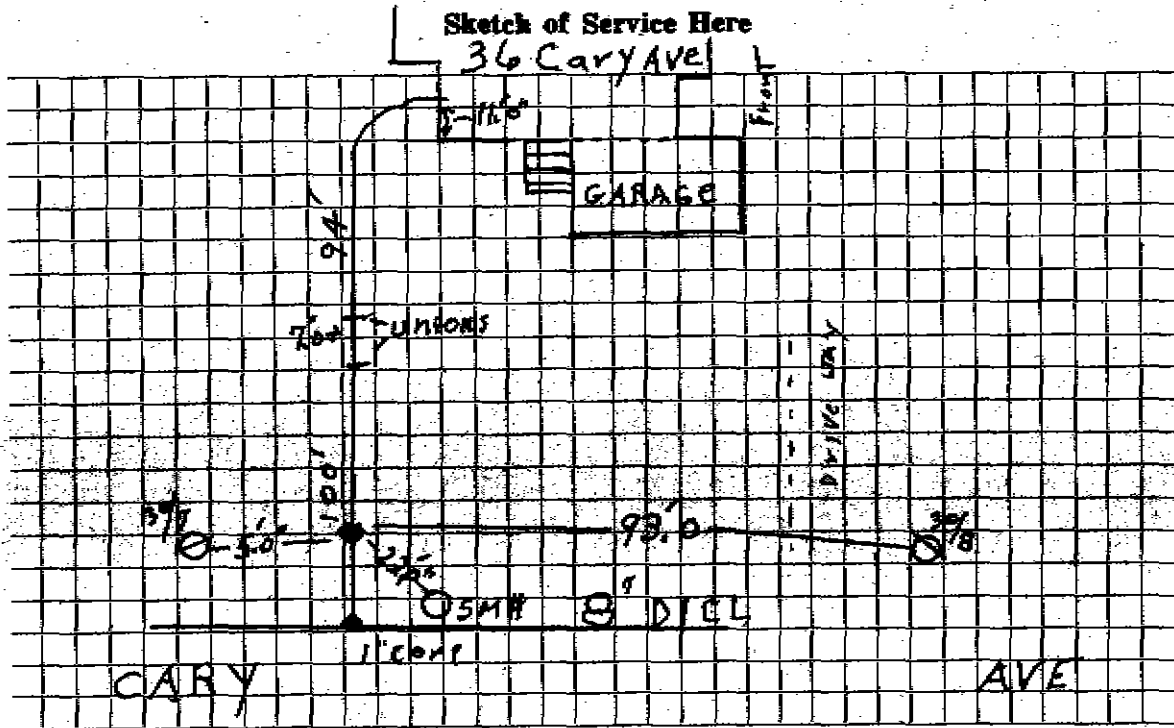

Connection made in Street. Work completed *J. McLaughlin 3/6/89*

Remarks:

.....

.....