

WATER SERVICE RECORD

Name

Service No.

Address *42 Cary Ave*

Location


Repair—Renewal—New Service

Date	Material	Amount	Total	Date	Amount
9-23-30	Inside				
	47' 1" Copper			9-11-96	Outside
	2 1" C. Couplings				27.6- 1" Copper
	1 1" Stop + Waste				1-1" Corp.
					1-1" Curb.
					1- Box

DATE _____

TOWN OF LEXINGTON — BOARD OF PUBLIC WORKS
WATER DIVISION

Sketch of Service Here

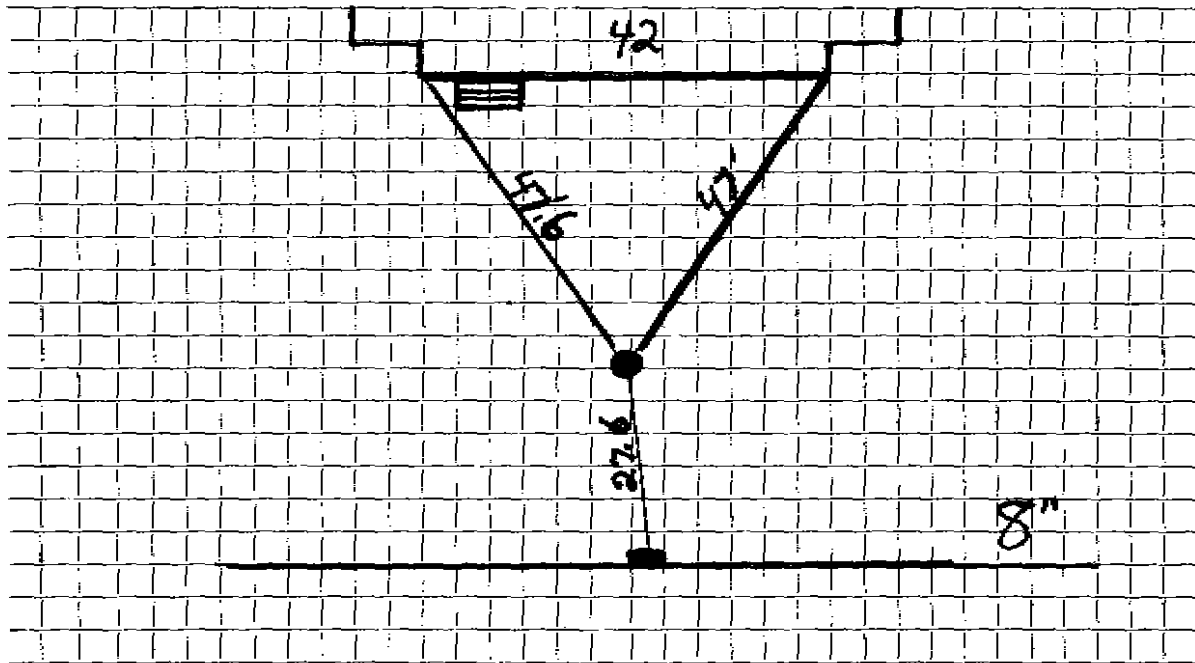

Connection made in Street. Work completed ... 9-11-96

Remarks:

.....

.....