

WATER SERVICE RECORD

Name

Service No.

Address

45 Cary Ave.

Location


Repair—Renewal—New Service

Date	Material	Amount	Total	Date	Amount
10-6-47	Inside				
	43' 3/4" Copper			9-9-96	Outside:
	1 3/4" x 1/2" l.w.H. Stop & Waste				8'-1" Copper
					1-1" Corp.
					1-1" Curb
					1- Box
					1- 1x3/4 Adapt.

DATE 11-18-96

TOWN OF LEXINGTON — BOARD OF PUBLIC WORKS  
WATER DIVISION

Sketch of Service Here

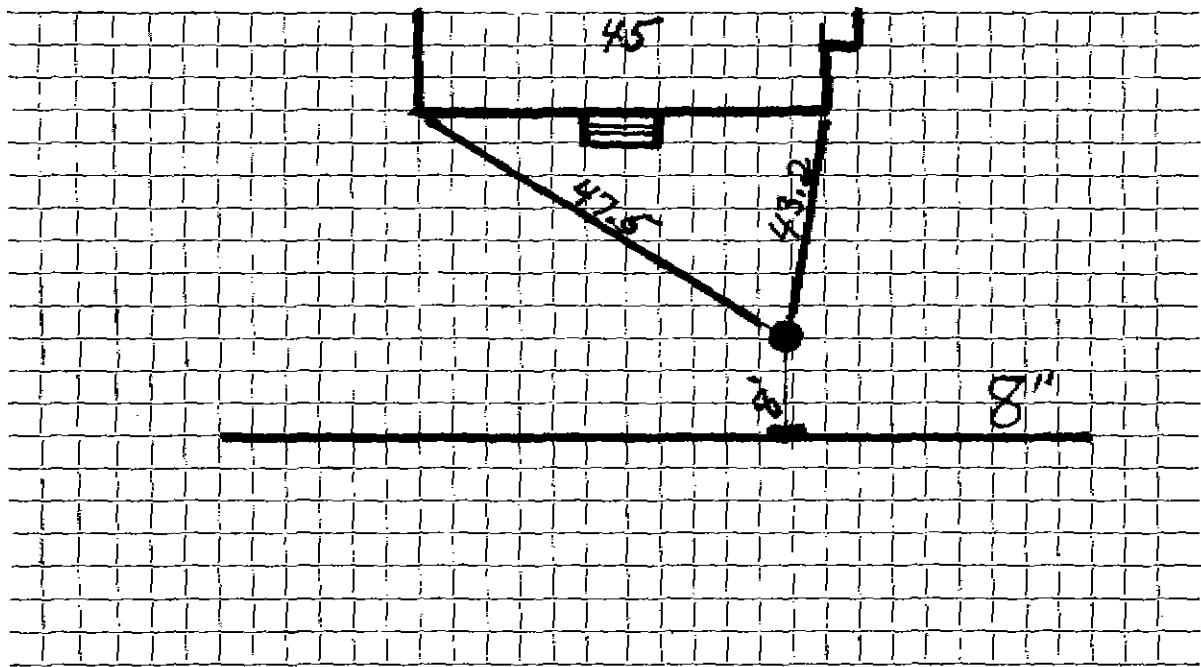

Connection made in ..... Street. Work completed 9-9-96.....

Remarks: .....  
.....  
.....