

WATER SERVICE RECORD

Name

Service No.

Address *47 Cary Ave*

Location


Repair—Renewal—New Service

Date	Material	Amount	Total	Date	Amount
8-21-47	Inside:				
	43' $\frac{3}{4}$ " Copper			9-10-96	Outside:
	1 $\frac{3}{4}$ " C. X $\frac{1}{2}$ " I. W. H. Stop & Waste				8'-1" Copper
					1-1" Corp.
					1-1" Curb.
					1- Box
					1-1X $\frac{3}{4}$ Adapt.

DATE 11-18-96

TOWN OF LEXINGTON — BOARD OF PUBLIC WORKS
WATER DIVISION

Sketch of Service Here

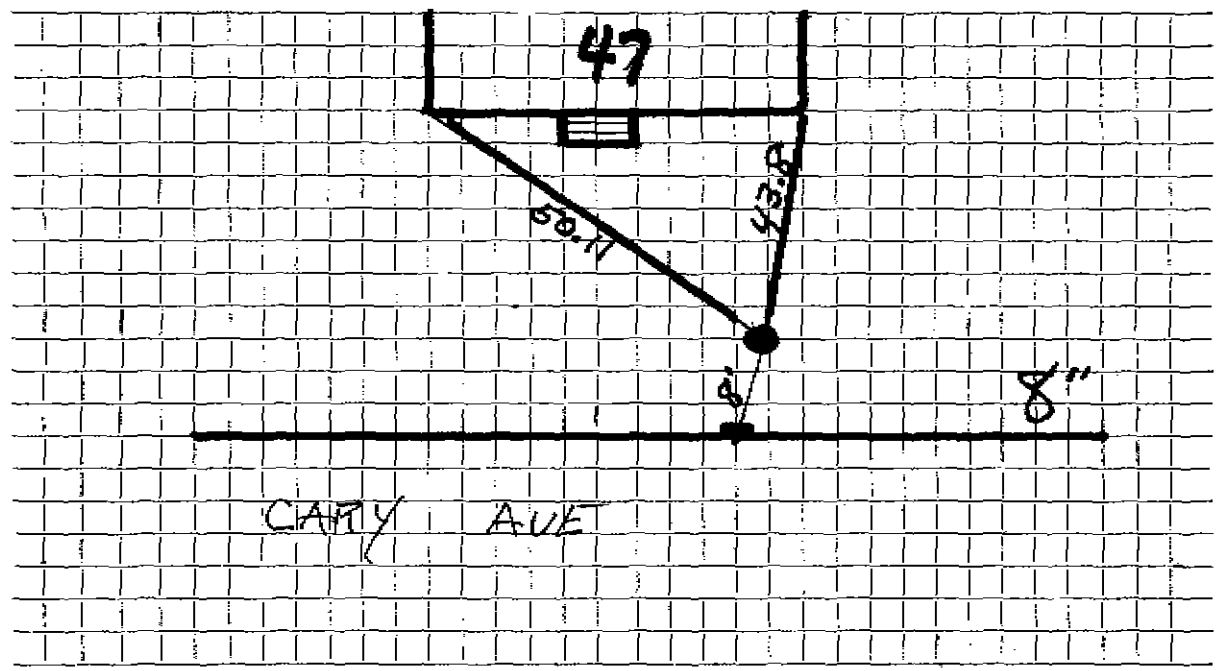

Connection made in Street. Work completed ... 9-10-96

Remarks:
.....
.....