


DATE 8-15-01

TOWN OF LEXINGTON — BOARD OF PUBLIC WORKS
WATER DIVISION

Sketch of Service Here
49 CARY AVE

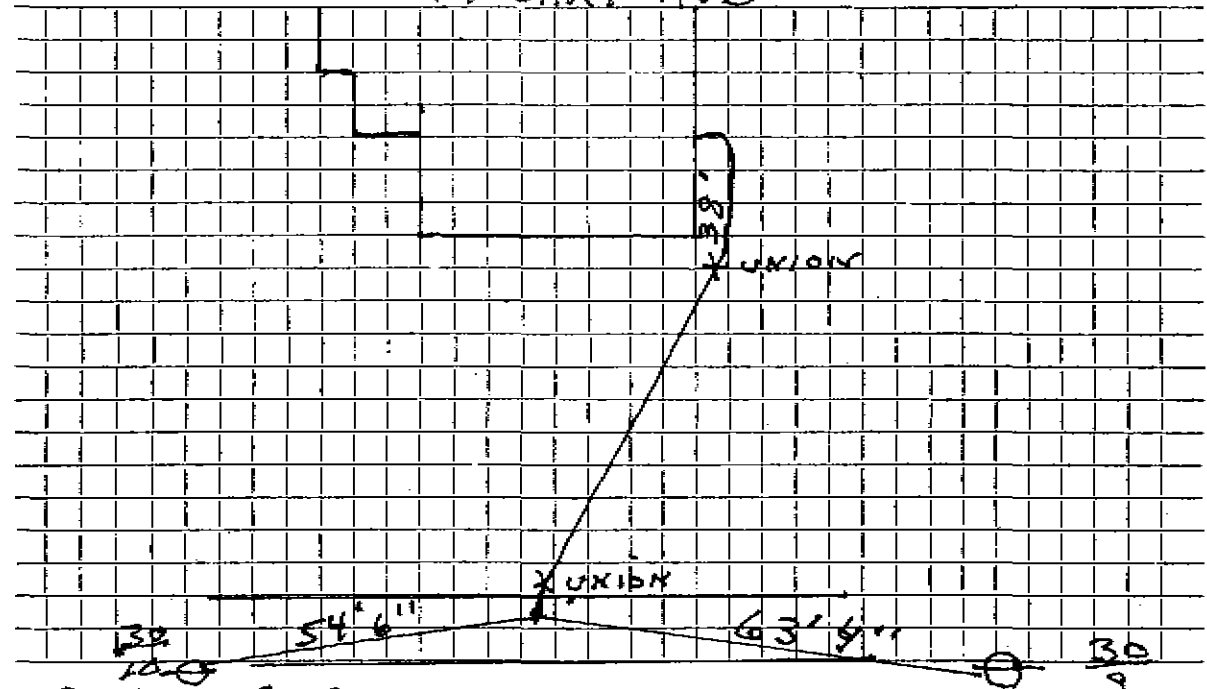

Connection made in ..CARY... AVE..... Street. Work completed

Remarks: