


DATE 8-26-96

TOWN OF LEXINGTON — BOARD OF PUBLIC WORKS

WATER DIVISION

Sketch of Service Here

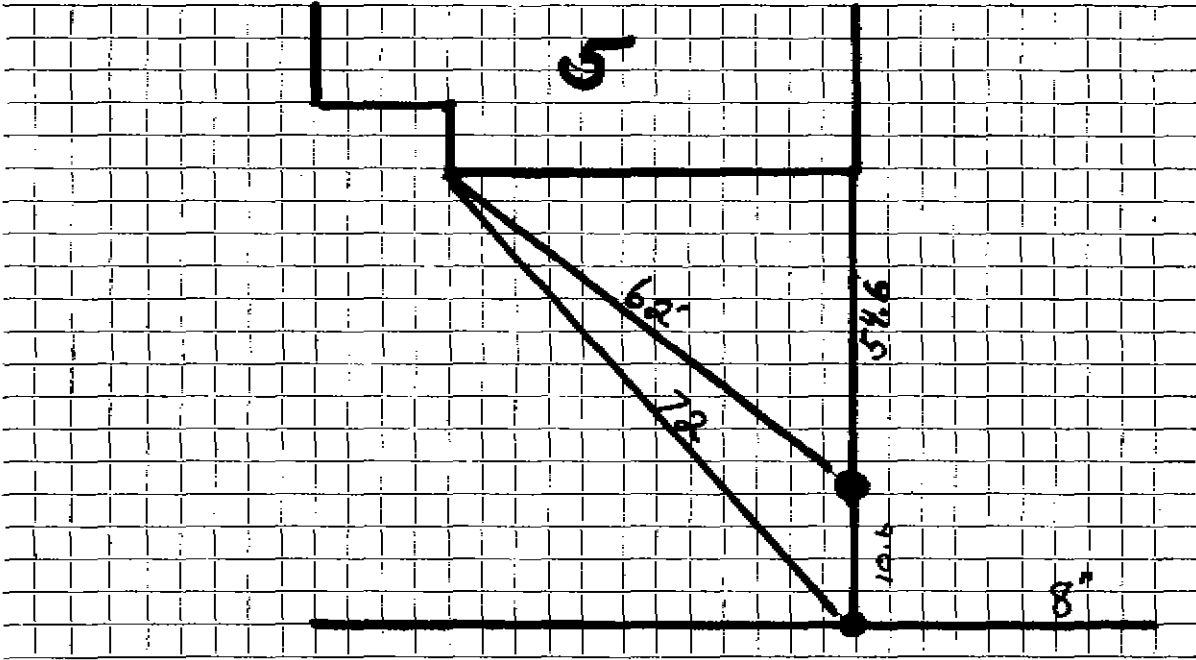

Connection made in Street. Work completed ... 8-26-96

Remarks:
.....
.....