

WATER SERVICE RECORD

Name

Service No.

Address 51 Cary Ave.

Location


Repair—Renewal—New Service

Date	Material	Amount	Total	Date	Amount
7-6-72	Inside			9-10-96	Outside
	70' 3/4" Copper				12' 1" Copper
					1 1" Corp Cock
					1 1" Curb Cock
					1 1" X 3/4" Adapter
					1 Box

DATE _____

TOWN OF LEXINGTON — BOARD OF PUBLIC WORKS
WATER DIVISION

Sketch of Service Here

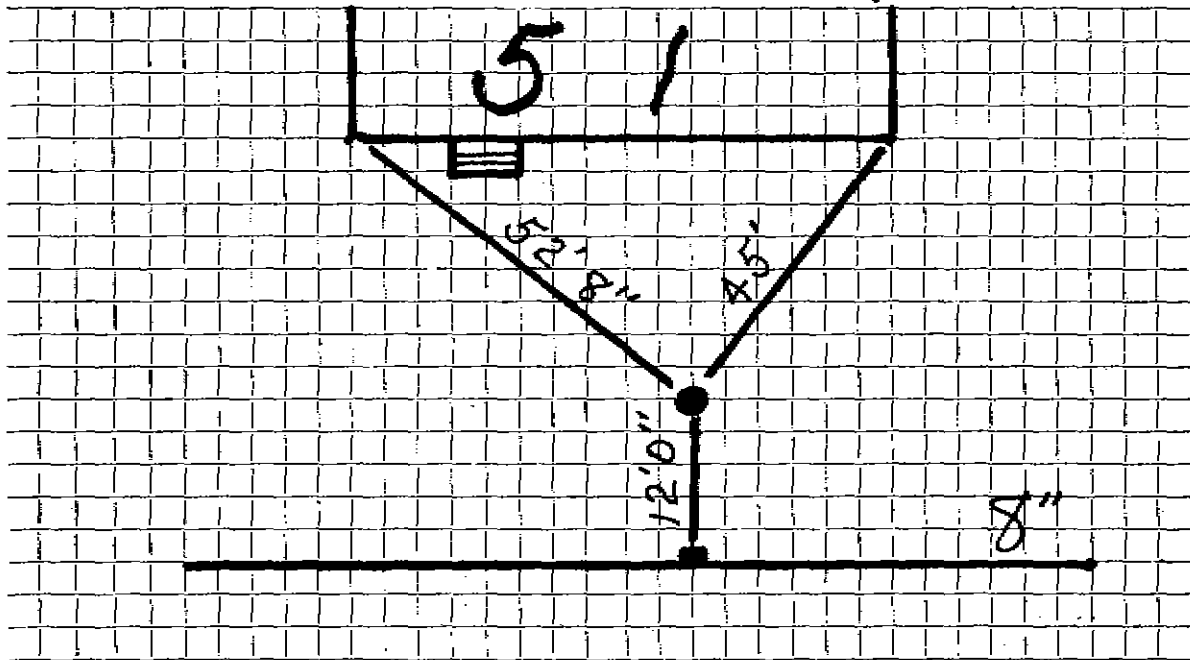

Connection made in Street. Work completed

Remarks:

.....

.....