


DATE 11-18-96

TOWN OF LEXINGTON — BOARD OF PUBLIC WORKS
WATER DIVISION

Sketch of Service Here

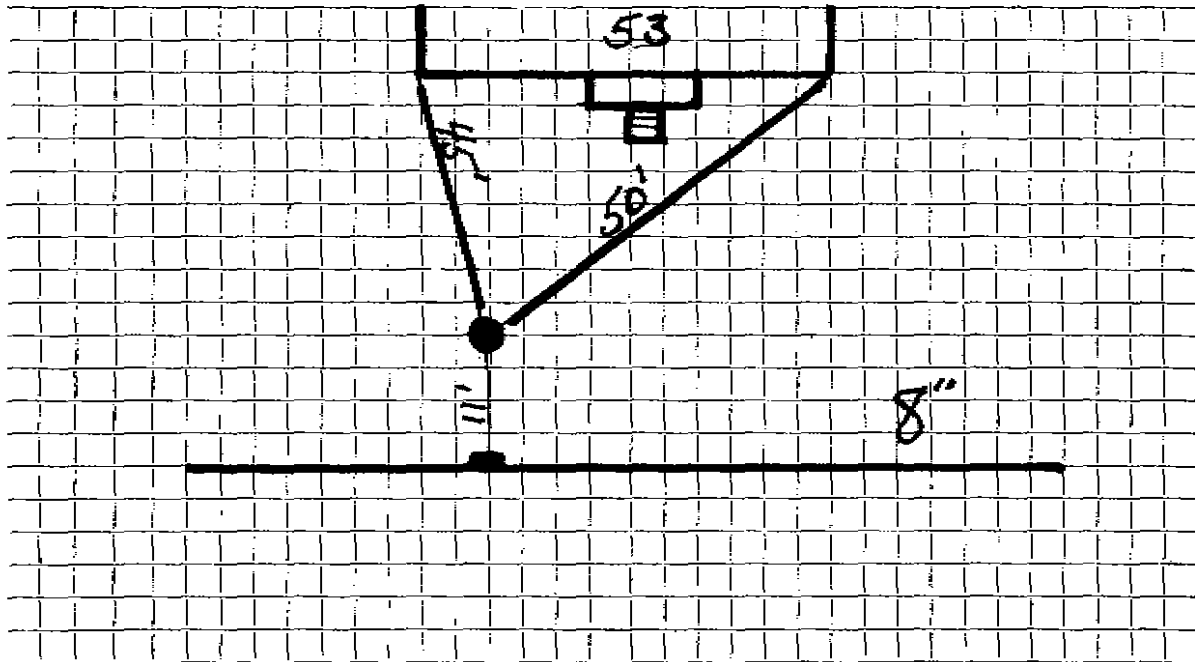

Connection made in Street. Work completed 9-10-96.....

Remarks: Inside Curb there is 13.6 of 1" Copper.....