




DATE 11-18-96

TOWN OF LEXINGTON — BOARD OF PUBLIC WORKS

**WATER DIVISION**

Sketch of Service Here

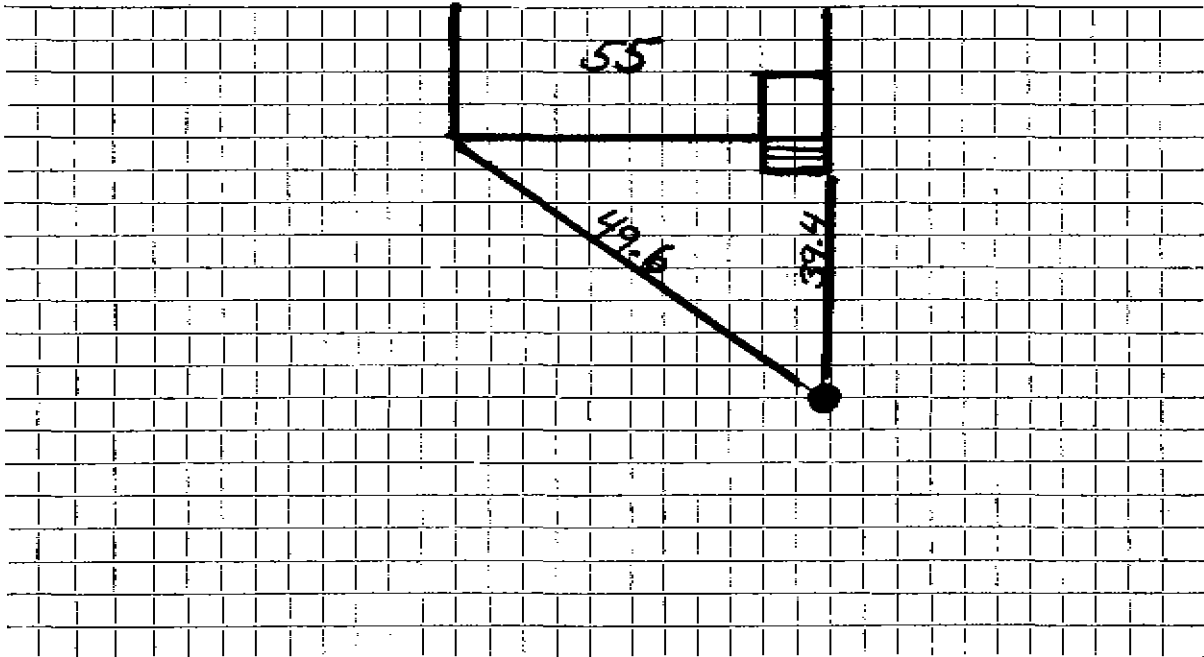

Connection made in ..... Street. Work completed 9-10-96.....

Remarks: .....  
.....  
.....