


DATE 6/20/8

TOWN OF LEXINGTON — BOARD OF PUBLIC WORKS
WATER DIVISION

Sketch of Service Here

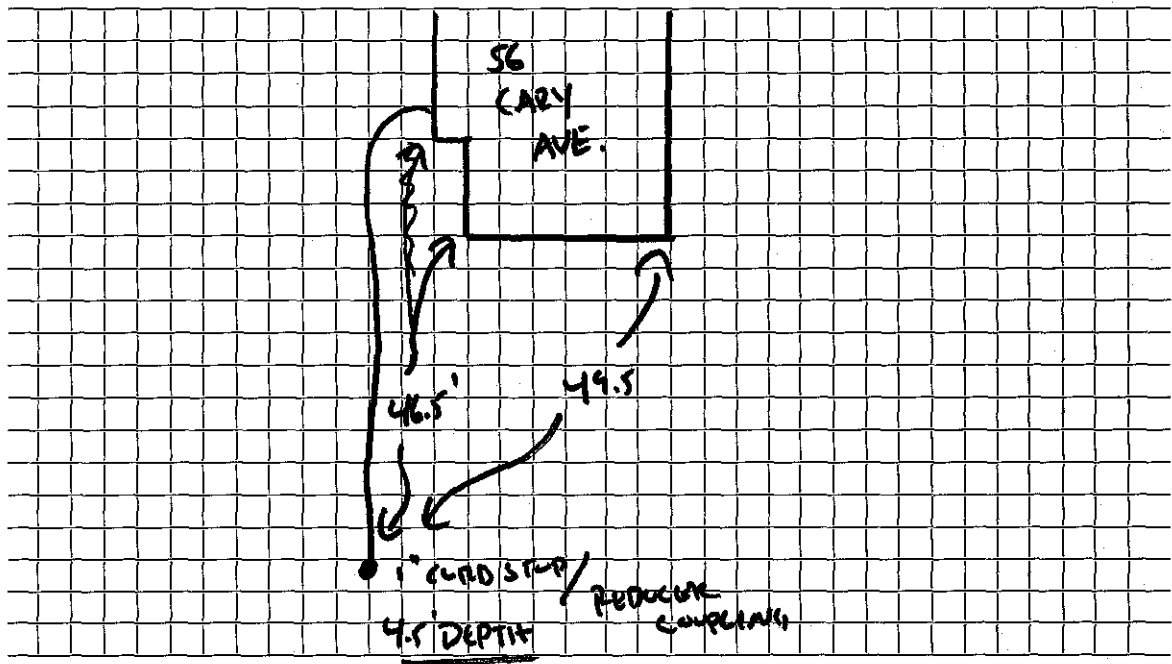

Connection made in ... CARY ... Street. Work completed ... STRONG BASIC SYSTEMS ...

Remarks:

.....

.....