

WATER SERVICE RECORD

Name

Service No.

Address

57 Cary Ave

Location

Repair—Renewal—New Service


Date	Material	Amount	Total	Date	Amount
8-12-64	Inside			Outside	
42'	3/4" Copper			9-10-96	12'-1" Copper
					1-1" Corp.
					1-1" Curb.
					1- Box
					1- 1x3/4 Adapt

DATE \_\_\_\_\_

TOWN OF LEXINGTON — BOARD OF PUBLIC WORKS

**WATER DIVISION**

Sketch of Service Here

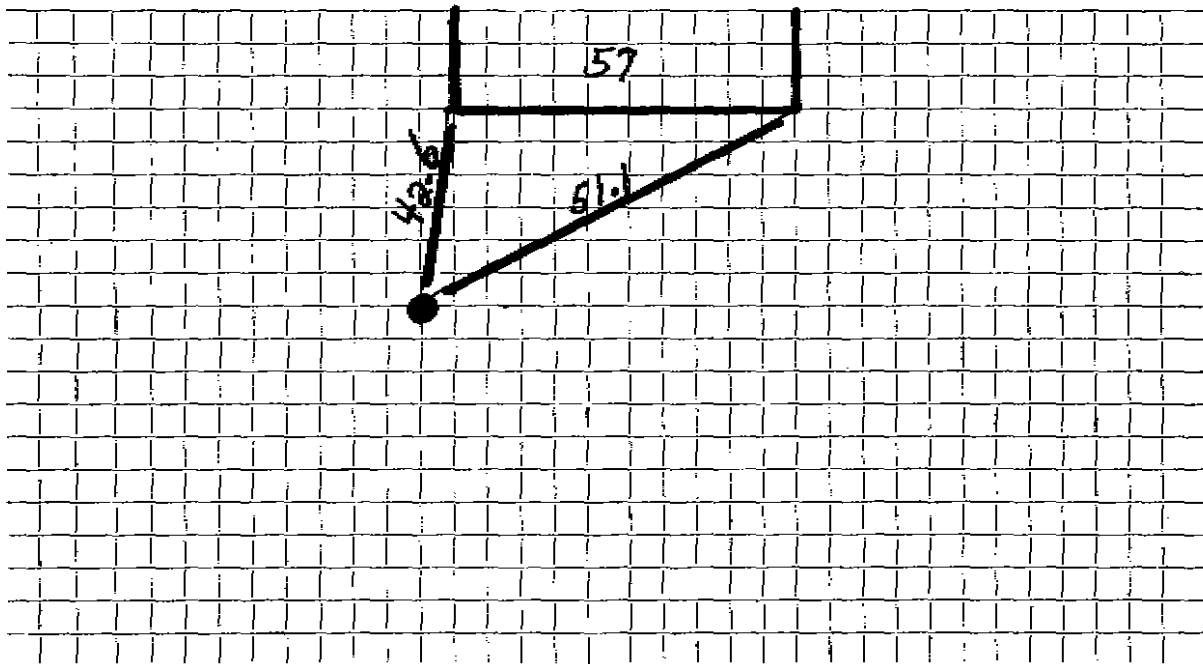

Connection made in ..... Street.

Work completed ... 9-10-96 .....

Remarks: .....  
.....  
.....