

WATER SERVICE RECORD

Name

Service No.

Address

59 Cary Ave

Location


Repair—Renewal—New Service

Date	Material	Amount	Total	Date	Amount
3-18-48	Inside				
	44' 3/4" Copper			9-10-96	Outside
	1 3/4" c. X 1/2" l. W. H. Stop & Waste				12'-1" Copper
	1 3/4" c. X 3/4" c. - 3 Part Union				1-1" Corp.
					1-1" Curb
					1-Box
					1-1x3/4 Adapt.

DATE _____

TOWN OF LEXINGTON — BOARD OF PUBLIC WORKS
WATER DIVISION

Sketch of Service Here

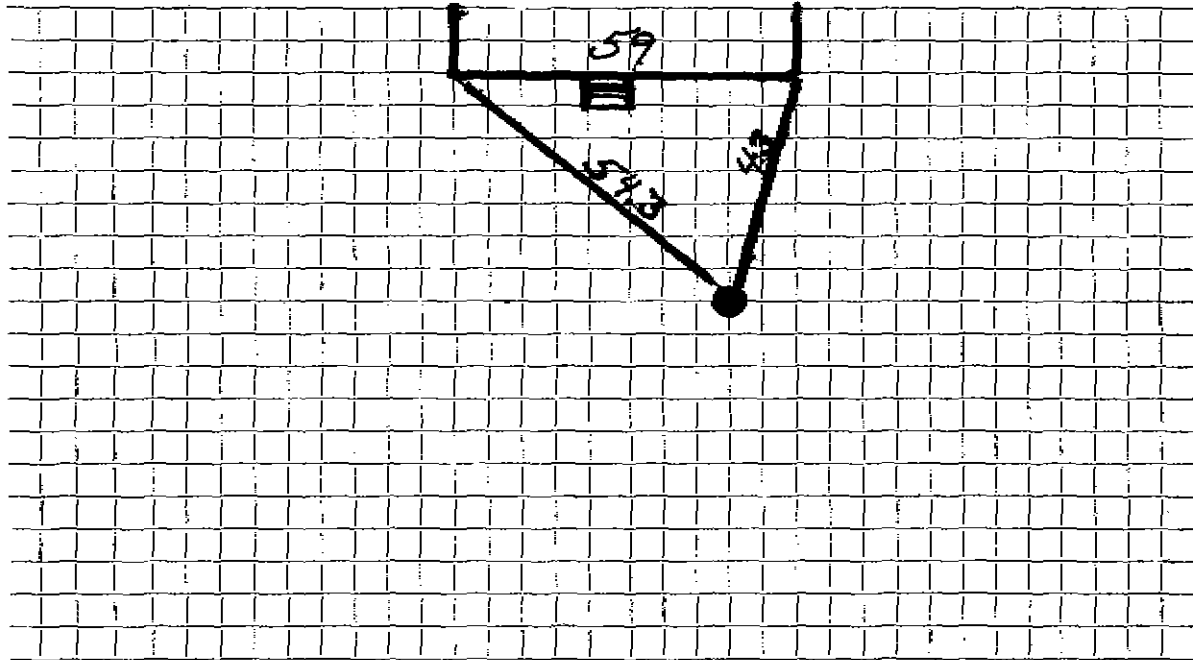

Connection made in Street. Work completed 9-10-96

Remarks: Box is 1' deep

.....
.....