




DATE 4/2018

TOWN OF LEXINGTON — BOARD OF PUBLIC WORKS

WATER DIVISION

Sketch of Service Here

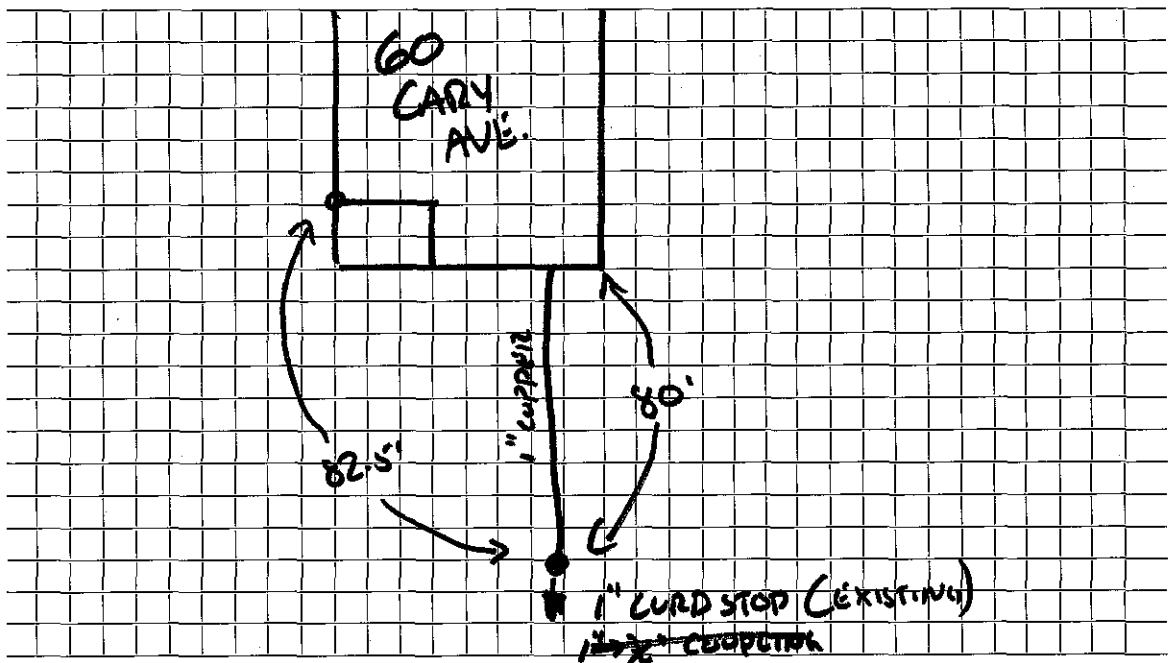

Connection made in... CARY ..... Street. Work completed .....

Remarks:.....  
.....  
.....