


DATE _____

TOWN OF LEXINGTON — BOARD OF PUBLIC WORKS

WATER DIVISION

Sketch of Service Here ✓

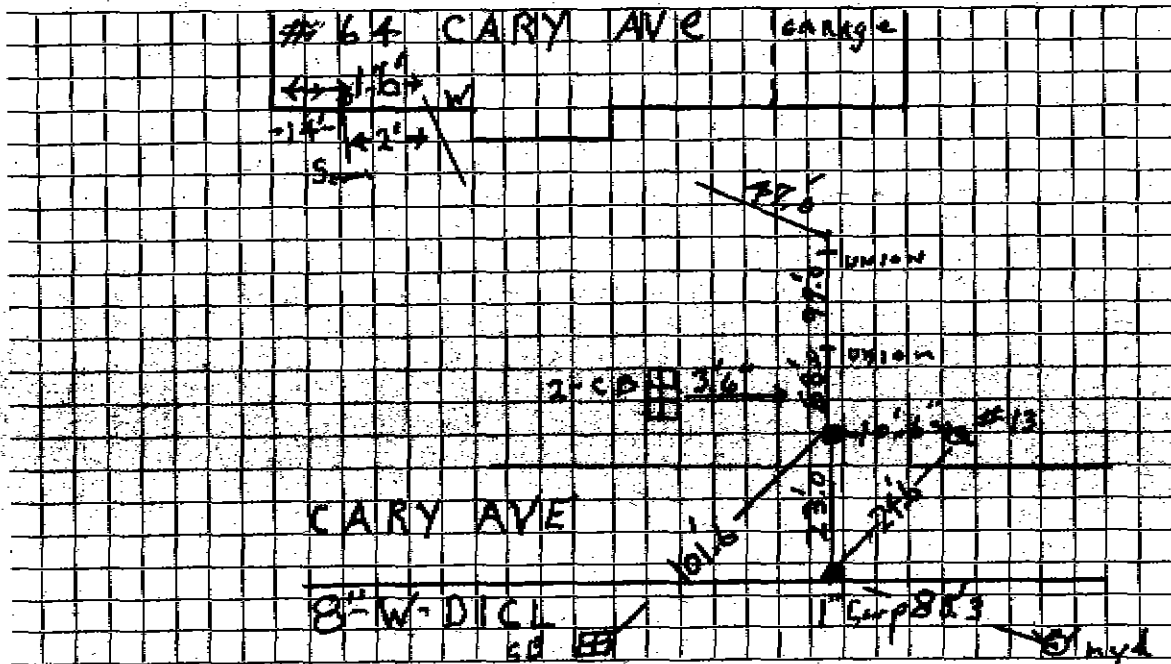

Connection made in _____ Street.

Work completed _____

J. McLaughlin

Remarks: INSIDE W + Service 2' APART