

WATER SERVICE RECORD

#5477

Name Charles Sweeney, Jr.

Service No. 79

Address 72 Cary Avenue

Location

~~Repair - Remount~~ - New Service


SERVICE WAS IN TO CURB

Date	Material	Amount	Total	Date	Amount
4/27/56	Labor	21 40		4-23-56	Deposit \$100 00
	10% overhead	2 14	23 54	8-6-56	Refund 12 50
	50' - 3/4" Copper tubing @ .4850	24 25			NON CHARGE 87 50
	1 - 3/4Cx 1/2 I.W.H. Stop & Waste	4 96		4/27/56	
	1 hr. trucking		75	1 - 1/2" Straight tailpiece	50
	4 hrs. Littlefield Shovel @8.50	34 00		1 - 1" Offset tailpiece	50
			87 50		1 00
				8/21/57	
				25'	3/4 COPPER
					#4 CORP
					1/4 CURB
					Box Rod

DATE _____

TOWN OF LEXINGTON — BOARD OF PUBLIC WORKS
WATER DIVISION

Sketch of Service Here

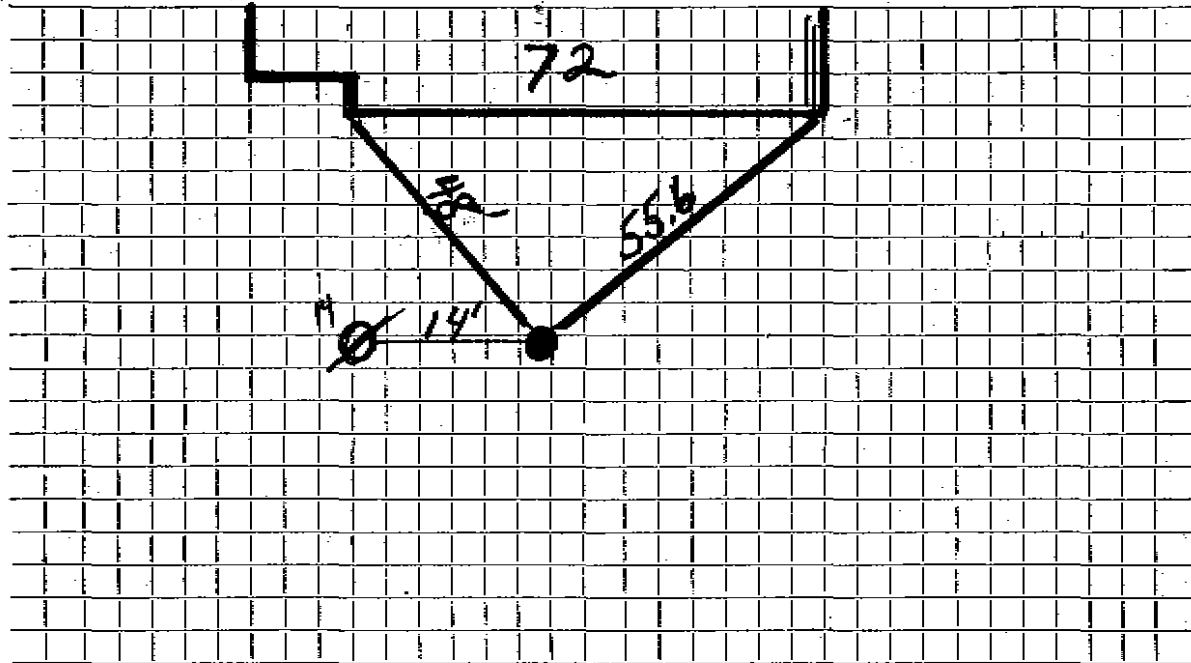

Connection made in Street. Work completed

Remarks:
.....
.....