
Name			SERVICE	RECOMB ⁱⁿ	to curb - charge whe	n conne	ct
Address	house #74 Cary A lot #120 Cary A	lve.					
	Lexington, Wass						
Renaik-XRene	New Service						
Date	Material	Amount	Total	Date		Amount	
				 			-
					NON THARGE		
				8/21/91 L		2	9
				25! 3/4"	Copper tubing @.326	8	ļı
				1 - 5/4"	C. corp-cock		3
				1 - 3/4"	x 3/4 " C. curb-co		 6'
				1 box and	J I	4	6
		 		l hr. tru	, - ·		7
		 		Brox dont:	raceor	50 75	
		 					۲Ť
			_ _	#			-
							
						.	
35.6		1 1					Γ.,

DATE	 	 	

TOWN OF LEXINGTON - BOARD OF PUBLIC WORKS WATER DIVISION

Sketch of Service Here

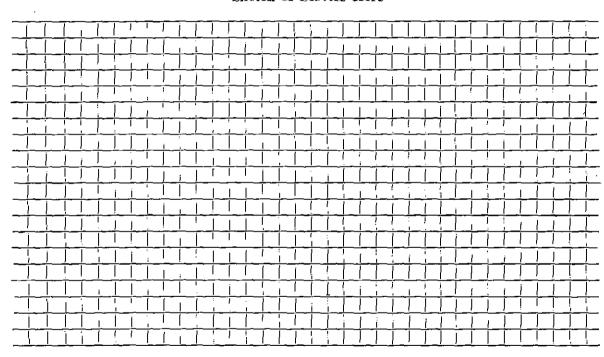

Connection	made in	Street.	Work	completed	4-1
Damanlan i	(phagosaatage+)pa <i>(etepene)pp</i> rotoshanrotophagosa(pt.HapasasHilperistandagoshanda)				***************************************
P.6+488; ***************		#1#;q;=+#4#1#1hqg;=hq;<6+# <i>q;<6+#4>#h</i> u;	pj by ad 81 b+a þ9	pa ka 1 154 ma 114 114 114 114 114	
		# P # P 4 P \$ 8 8 8 8 9 9 9 9 9 9			pq 4 <i>4 kg 4 / 4 pg bd b</i> q pq bq 5d b8 bq b4 Pq 6d 68 bg 1 d 2q 6 p8 8 1 g 2q bq bg