

main to curb - charge when connected
WATER SERVICE RECORD

Name **Frank Conti**
 house #76 Cary Ave.
 Address lot #121 Cary Ave.

Service No. **221**

6225

Location **Lexington, Mass.**

~~REPAIR SERVICE~~ - New Service


Comm. 11-30-59

Date	Material	Amount	Total	Date	Amount
9-16-59	Labor	23 40		9-9-59	Deposit 45 00
	10% O. H.	2 34	25 74	12-14-59	Paid 25 22
	60' 3/4" Copper tubing @.41		24 60		<u>NOA CHARGE</u> 70 22
	1 3/4" C x 1/2 I.W.H. Stop & Waste	5 88	8/21/51	Labor	2 98
	2 Hrs. Trucking @.75	1 50		25' - 3/4" copper tubing @ .326	8 15
	2 Hrs. Town Shovel @6.50	13 00		1 - 3/4" C. corp-cock	4 33
	20 x 3 Patch		20 00	1 - 3/4" C x 3/4" C. curb-cock	4 67
			90 72	1 box ard rod	4 68
				1 hr. trucking	75
				Brox contractor	50 00
					<u>75 56</u>
				9-16-59	Labor 8 25
				21' 3/4" Copper tubing @.41	8 61
				1 3/4" C Corp Cock	4 67
				1 3/4" C Curb Cock	5 98
				1 Box & Rod	5 00
				1 1/2 Straight Tailpiece	50
				1 1/2 Offset Tailpiece	50
				1 Hr. Town Shovel @6.50	6 50
					<u>40 01</u>

DATE _____

TOWN OF LEXINGTON — BOARD OF PUBLIC WORKS
WATER DIVISION

Sketch of Service Here

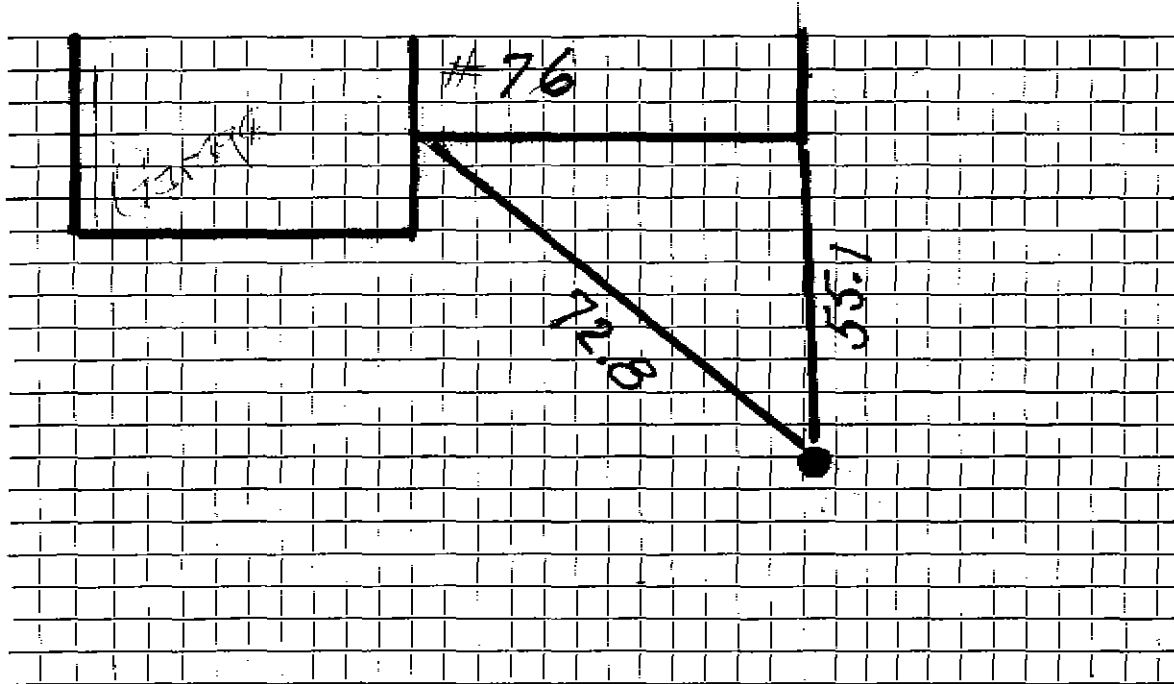

Connection made in Street. Work completed

Remarks:

.....
.....