

WATER SERVICE RECORD

Name

Service No.

Address 8 Cary Ave

Location


Repair—Renewal—New Service

Date	Material	Amount	Total	Date		Amount
9-10-50	Inside				Outside	
	45' $\frac{3}{4}$ " Copper			9-26-96	27'-1" Copper	
	1 $\frac{3}{4}$ " C X $\frac{1}{2}$ " I.W.H.				1-1" Corp	
	STop + Waste				1-1" Curb	
					1-1x $\frac{3}{4}$ Adapt.	
					1- Box	

DATE _____

TOWN OF LEXINGTON — BOARD OF PUBLIC WORKS
WATER DIVISION

Sketch of Service Here

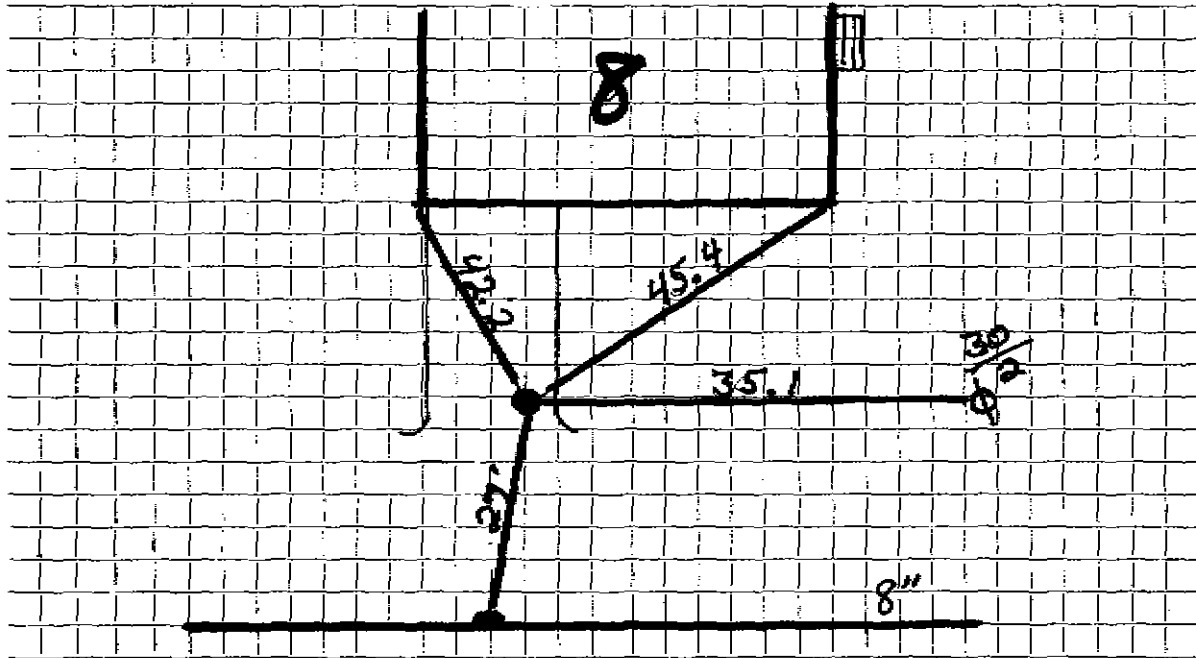

Connection made in Street.

Work completed 9-26-96

Remarks:
.....
.....