

WATER SERVICE RECORD

2392
Service No. 254

Name V. Vergardos

Address 90 Cary Ave., Lexington, Mass.

Location

~~Repair - Renewal~~ - New Service

Comm. 12/31/57

Date	Material	Amount	Total	Date	Amount
11/8/57	Labor	14 51		10-29-57	Deposit * 75 00
	10% Overhead	1 45	15 96	12-31-57	Refund (24 63
	60'-3/4" Copper tubing @.37		22 20		* 50 37
	1-3/4" Cx 1/2 IWH stop & waste		4 96		Non Charge
	1 hr. Trucking @.75		75		1-3/4" C Curb Cock 5 94
	1 hr. Town Shovel @ 6.50		6 50		Labor 2 04
			50 37		1 Bow & Rod 4 62
					1-1" Cx 1" I-2 Part Union 1 40
					14 00


#82, 90 Cary Ave. is the service for the old #84 check
(barned down) #84

DATE _____

TOWN OF LEXINGTON — BOARD OF PUBLIC WORKS

WATER DIVISION

Sketch of Service Here

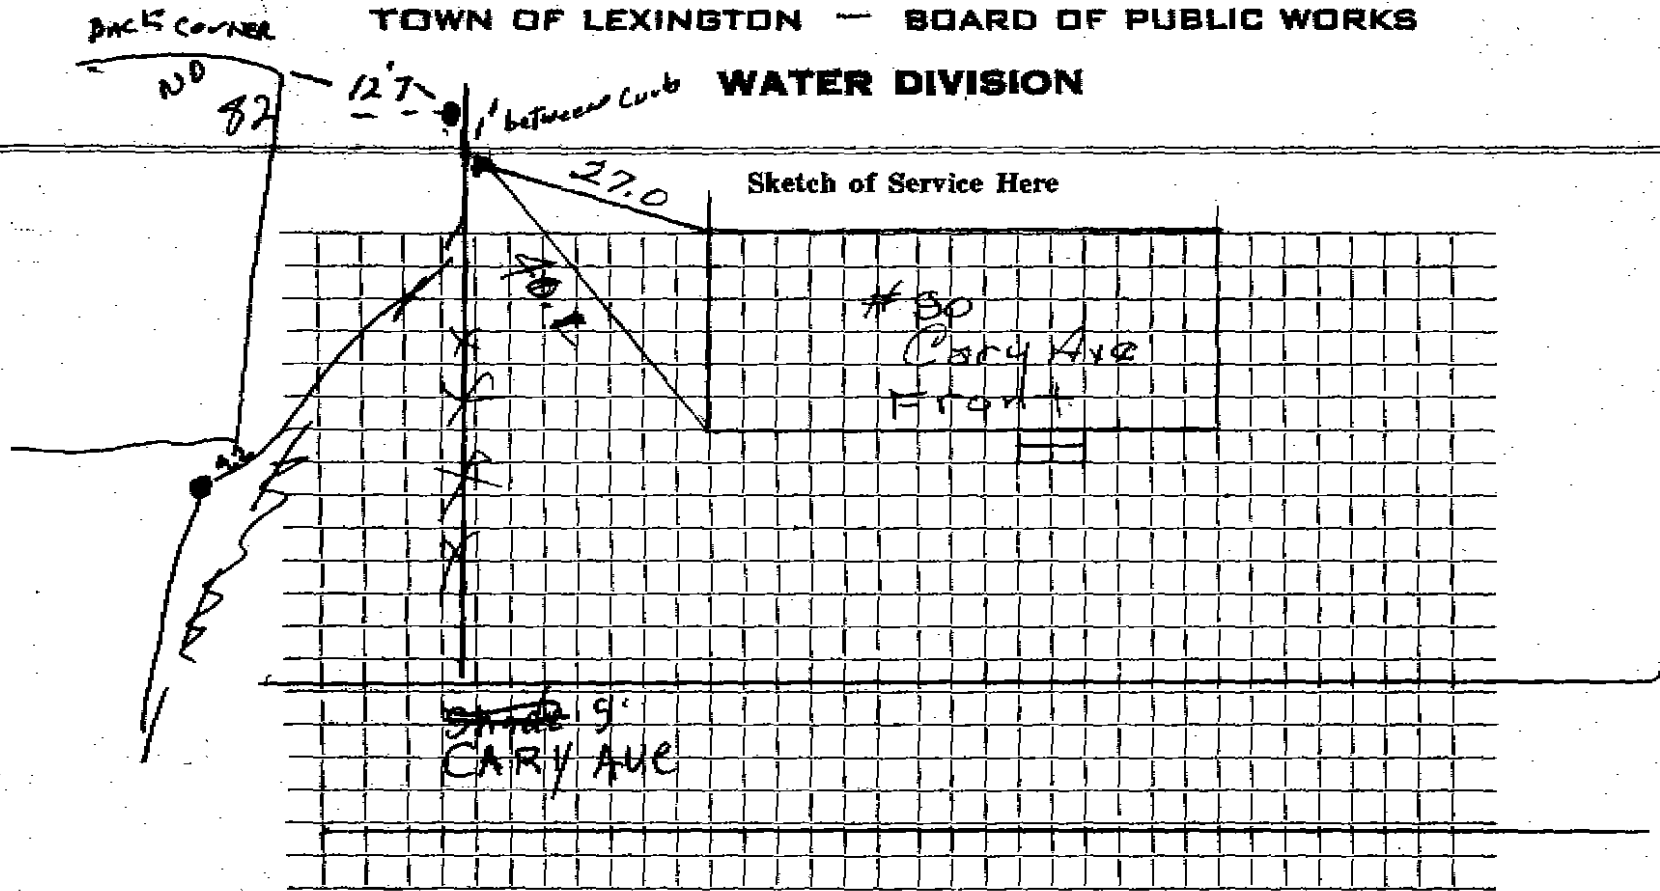

Connection made in Street: Work completed

Remarks: # 82, 80 use the same service (from # 84 Main St. Club # bernal aborn).....