

Main to curb- charge when connected

WATER SERVICE RECORD

Name

Service No.

Address house #98 Cary Avenue
lot at Cor. Cary Ave. & Shade St.
Location (same side as Mohawk Club)

~~Repair/General~~ - New Service


| Date | Material | Amount | Total | Date | Amount |
|---------|------------------------|--------|-------|---------|------------------------------------|
| 7/23/54 | | | | | |
| | 45' 3/4 COPPER | | | | |
| | 1 3/4 X 1/2 STOP+WASTE | | | | |
| | | | | | <u>NO CHARGE</u> |
| | | | | 8/23/54 | labor 2 98 |
| | | | | | 25' -3/4" copper tubing@.326 8 15 |
| | | | | | 1 -3/4" C. corp-cock 4 33 |
| | | | | | 1 -3/4" C x 3/4" C. curb-cock 4 67 |
| | | | | | 1 box and rod 4 68 |
| | | | | | 1 hr. trucking 75 |
| | | | | | Brox contractor 50 00 |
| | | | | | <u>75 56</u> |

DATE _____

TOWN OF LEXINGTON — BOARD OF PUBLIC WORKS

WATER DIVISION

Sketch of Service Here

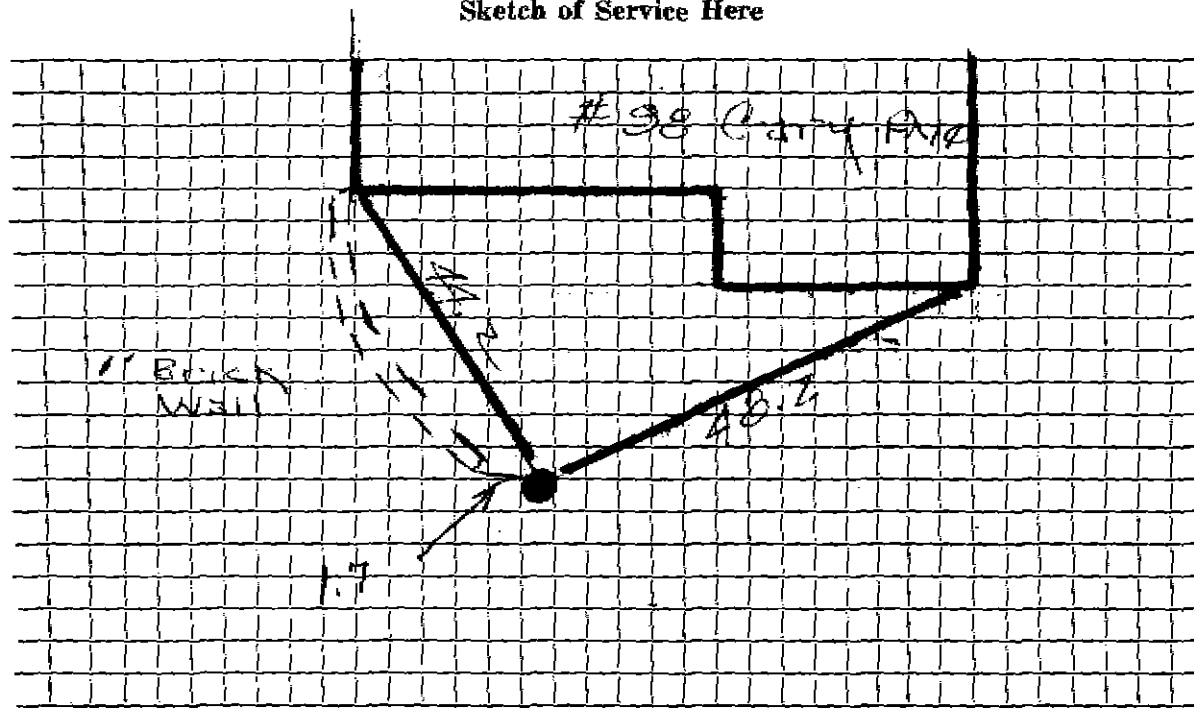

Connection made in Street. Work completed

Remarks:

.....

.....