

WATER SERVICE RECORD

Name William Bertozzi

Service No. 74

Address 8 Castle Road

Location

Repair—Renewal—New Service

W. O. # 221

DeFlice #2226

~~XXXXXXXXXXXX~~


Date	Material	Amount	Total	Date	Amount
11/6/72	Labor	14 90		10/27/72	150 00
	10% O.H.	1 49	16 39	2/12/73	55 45
43'	1" Copper pipe .99		42 57		94 55
	1" Corportion		10 66		
	1" Curb Stop		14 43		
	Box & Rod		7 50		
1	Hr. Truck		3 00		
			94 55		
11/7/72	40' 1" Copper				

DATE _____

TOWN OF LEXINGTON — BOARD OF PUBLIC WORKS

WATER DIVISION

Sketch of Service Here

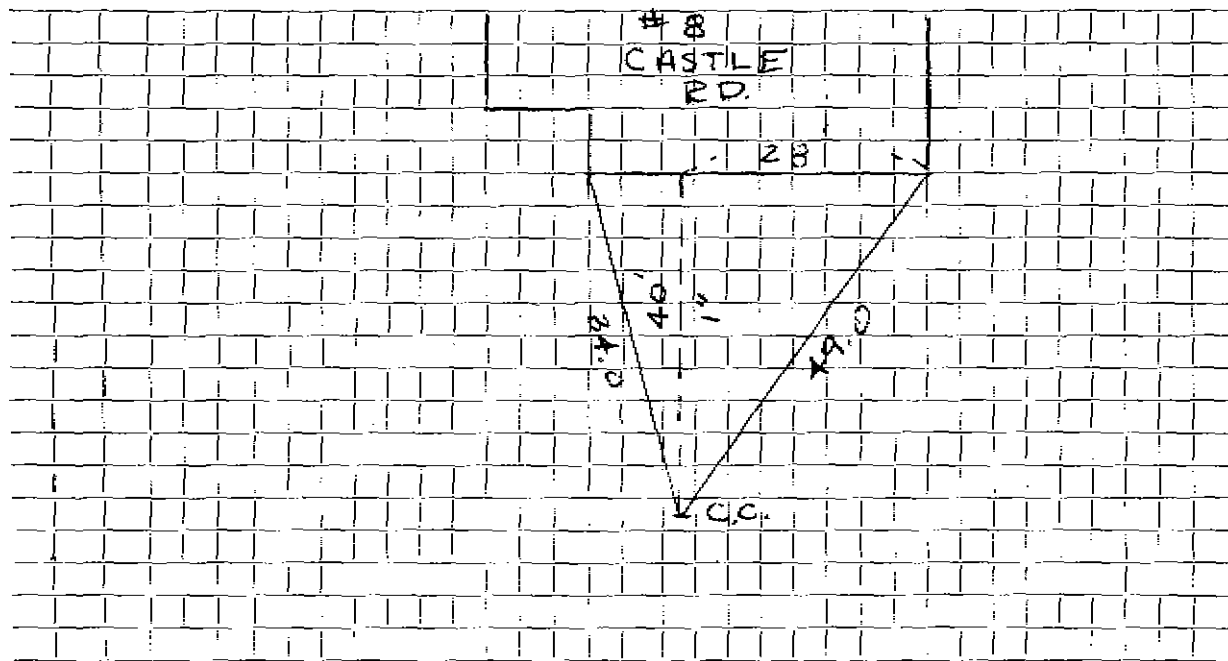

Connection made in Street. Work completed

Remarks:
.....
.....