

WATER SERVICE RECORD

Name Stanley Janusas

Service No. 96

Address 103 Cedar St.

Location Lexington

~~REPAIR GENERAL~~—New Service COM. 6-8-53


Date	Material	Amount	Total	Date	Amount
5/18/53	Labor	8 35		5-14-53 Deposited	60 00
	10% overhead	84	9 19	6-8-53 Refunded	(13 10)
	14'-3/4" Copper Tubing @.34		14 96		NON CHARGE 46 90
	1-3/4" C x 1/2 I.W.H. STOP & WASTE		4 00	5/18/53 Labor	8 34
	2 Hr. Littlefield Shovel @7.50		15 00	14'-3/4" Copper Tubing @.34	4 76
	1 Hr. Trucking		75	1-3/4" C. Corp-cock	4 33
	Patching 3 x 3		3 00	1-3/4" C. x 3/4" C. Curb-cock	4 67
			46 90	1-Box & Rod	3 90
				1-1/2 offset tail piece	50
				1-1/2 straight tail piece	50
				1 Hr. Littlefield Shovel	7 50
				1 Hr. Trucking	75
					35 25

DATE _____

TOWN OF LEXINGTON — BOARD OF PUBLIC WORKS

WATER DIVISION

Sketch of Service Here

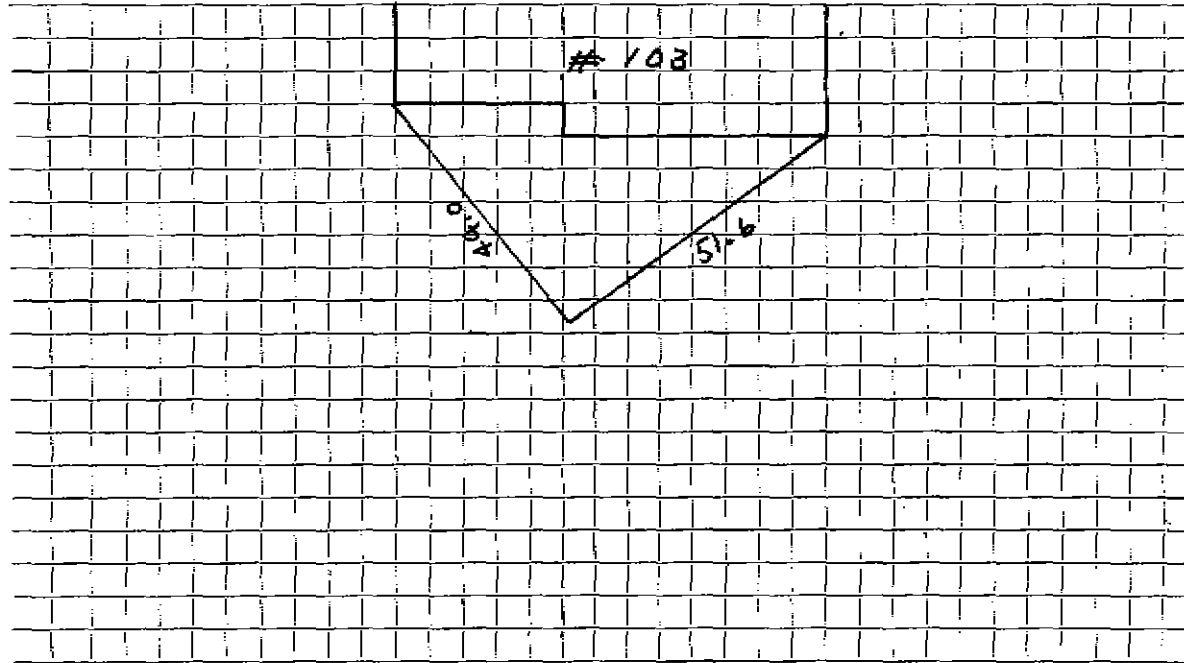

Connection made in Street. Work completed

Remarks:
.....
.....