

Name Wilbur L. Neal
 Address 107 Cedar Street
 Lexington, Mass.

Service No.

6020

Location 107 Cedar Street

Kind of Pipe

Size

Size of Main

~~Repair-Renewal~~—New Service

Location

Date	Material	Amount	Total	Date	Amount
Sept. 7, 1948	Labor	1 15	1 15	Aug 26 48	40 00
	20' Overhead		12	Sept 28 48	20 35
	45' - 3/4" Copper tubing @ .255	11 18	11 18	<i>Refunded</i>	
	1 - 3/4" C x 3/4" I.D.F. S	3 15	3 15	<i>Non-Charge</i>	
	Trucking 1 hr. @ .75	75	75	Sept. 7, 1948	2 20
	Patching 3 x 3	3 00	3 00	9' - 3/4" Copper tubing @ .255	2 30
			19 65	1 - 3/4" C Corp-cock	3 00
				1 - 3/4" C x 3/4" C Corp-cock	3 68
				1 - box & lid	3 55
				Littlefield Shovel 1 hr. @ 7.00	7 00
				1 - 3" Offset Tail Piece	30
				1 - 3" Straight Tail Piece	30
				Trucking 1 hr. @ .75	75
					23 08

Com. 10/25/48

trench dug by owner

Labor

DATE _____

TOWN OF LEXINGTON—BOARD OF PUBLIC WORKS

WATER DIVISION

The undersigned applies for a supply of water at No. _____ St. and hereby agrees to comply with the rules and regulations as now, or at any future time, established by the Board of Selectmen.

Am't. of Estimate \$ _____


Owner _____

Am't. Paid \$ _____

Address _____

Builder _____

Sketch of Service Here

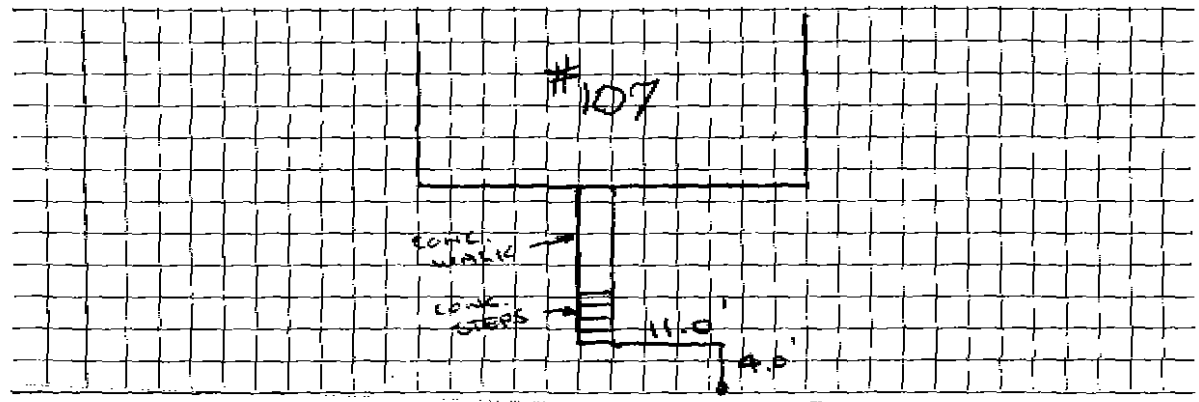

Connection made in _____ Street. (SHUT-OFF 4.0' OFF ROAD ALSO) Work completed _____ 19__

Remarks: