

WATER SERVICE RECORD

Name William Furdon

Service No. 191

Address 111 Cedar Street

Location Lexington 73, Mass.


~~Repair~~ ~~Renewal~~ New Service *Com. 10/1/51*

Date	Material	Amount	Total	Date	Amount
8-14-51	Labor	1 49	1 49	8-15-51	Deposited 50 00
	10% Overhead		75	10-1-51	Refunded 18 86
	33'-3/4" Copper Tubing @.326		10 75		<u>31 14</u>
	1-3/4" ex 1/2 I.W.H. S&W		4 00		No Charge
	2 Hr. Littlefield Shovel		11 00	8-14-51	Labor 1 49
	1 Hr. Trucking		75		12'-3/4" Copper Tubing @.326 3 91
			31 14		1-3/4" C. Corp-Cock 4 33
					1-3/4" Cx3/4" C Curb-Cock 4 67
					1-Box & Rod 4 68
					1-1/2 Offset Tail Piece 50
					1-1/2 Straight Tail Piece 50
					1 Hr Littlefield Shovel 7 00
					1 Hr. Trucking 75
					<u>27 83</u>

DATE \_\_\_\_\_

**TOWN OF LEXINGTON — BOARD OF PUBLIC WORKS  
WATER DIVISION**

Sketch of Service Here

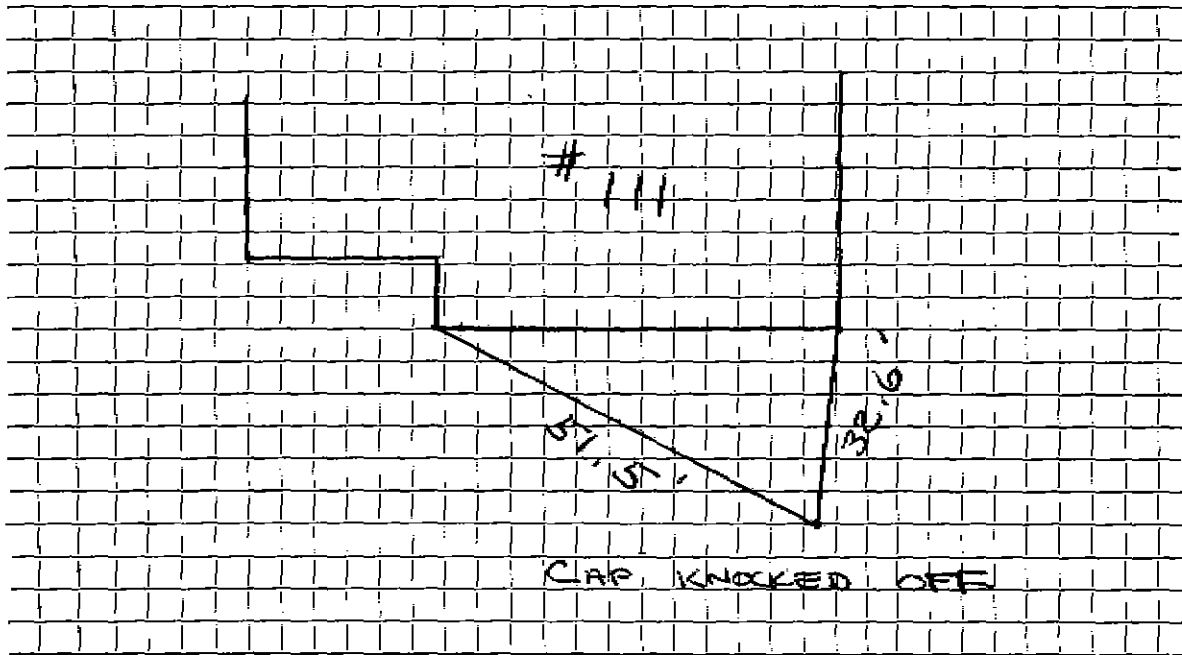

Connection made in ..... Street. Work completed .....

Remarks: .....

.....

.....