

WATER SERVICE RECORD

Name I. J. Nielsen

Service No. 9

Address 114 Cedar Street

#6843

Location Lexington, Mass.

~~Repair~~ ~~Renewal~~ - New Service

Com. 5-21-51


Date	Material	Amount	Total	Date	Material	Amount
3-10-51	Labor	6 00	6 00	Jan 11 51	& Deposited	75 00
	10% Overhead		60	11-2-51	Quoted	17 32
	60' - 3/4" Copper Tubing @.36	21 60	21 60		No Charge	53 67
	1 - 3/4"C x 1/2" I.W.H. S&W	4 00	4 00	3-10-51	Labor	7 90
	1 - 3/4"C x 3/4"C Unions (3pts)	1 72	1 72		12' - 3/4" Copper Tubing @.36	4 32
	Littlefield Shovel 3 hrs. @ 7.00	21 00	21 00		1 - 3/4" C Corp-cock	4 33
	Trucking 1 hr. @.75	75	75		1 - 3/4"C x 3/4"C Curb-cock	4 67
			55 67		1 - Box & Rod	4 68
					1 - 1/2" Straight Tail Piece	50
					1 - 1/2" Offset Tail Piece	50
					Littlefield Shovel 1 hr. @ 7.00	7 00
					Trucking 1 hr. @.75	75
						34 65

DATE _____

TOWN OF LEXINGTON — BOARD OF PUBLIC WORKS

WATER DIVISION

Sketch of Service Here

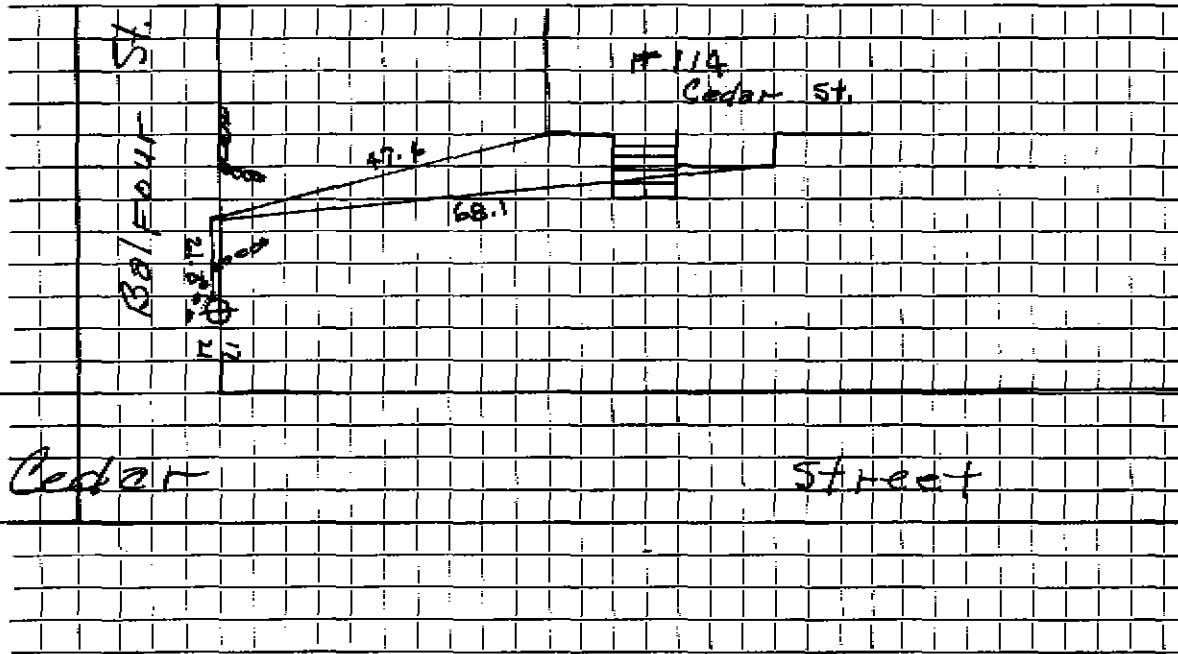

Connection made in Street. Work completed

Remarks:

.....

.....