

Name Richard Martin
 Address 117 Cedar Street
 Lexington, Mass.

Service No. 614
 #6083

Location 117 Cedar Street

Kind of Pipe Size Size of Main
 Repair ~~Renewal~~ - New Service Location

Date	Material	Amount	Total	Date	Amount
Sept. 23, '48	Labor	1 25	1 25	Sept 19 48	35 00
	10% Overhead		13	Sept 27 48	
	47' - 3/4" Copper Tubing	2.255	12 99		92 27
	1 - 3/4" C x 1/2" I.W.T. S		3 15		
	Trucking 1 hr.	.75	75	Sept. 23, '48	4 20
	patching 5 x 3		5 00	13' - 3/4" Copper Tubing	3 32
			22 27	1 - 3/4" C Corp-cock	3 00
				1 - 3/4" C x 3/4" C Curb-cock	3 68
				1 - Box & Rod	3 35
				1 - 3" Straight Tail Piece	30
				1 - 1/2" Offset Tail Piece	30
				Littlefield Shovell 1/2 hrs.	10 50
				Trucking 1 hr.	75
					29 60

Com 10/25/48

trench dug by owner.

Labor

Hadley Press, Inc., Lexington

DATE _____

TOWN OF LEXINGTON—BOARD OF PUBLIC WORKS

WATER DIVISION

The undersigned applies for a supply of water at No. _____ St. and hereby agrees to comply with the rules and regulations as now, or at any future time, established by the Board of Selectmen.

Am't. of Estimate \$ _____


Owner _____

Am't. Paid \$ _____

Address _____

Builder _____

Sketch of Service Here

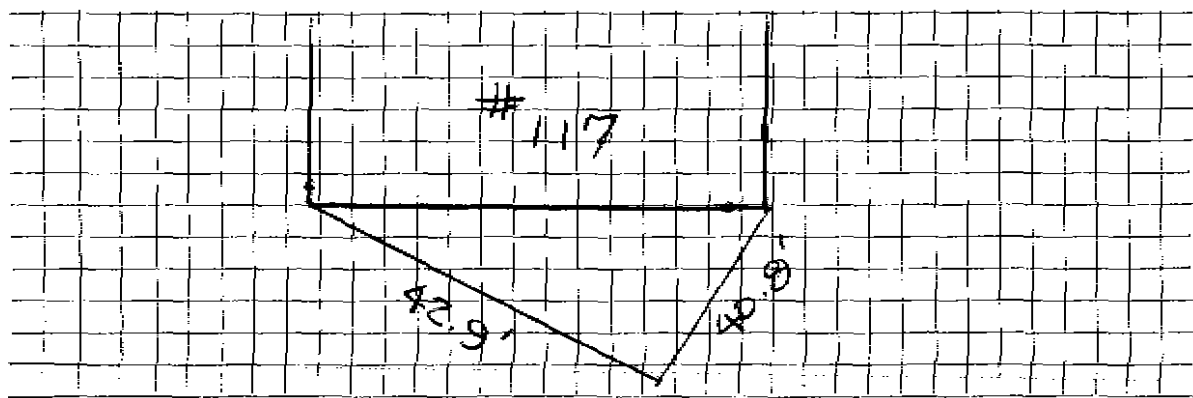

Connection made in _____ Street.

Work completed _____ 19

Remarks: