


TOWN OF LEXINGTON - BOARD OF PUBLIC WORKS  
WATER DIVISION

Date: 4/29/21

SKETCH OF SERVICE HERE

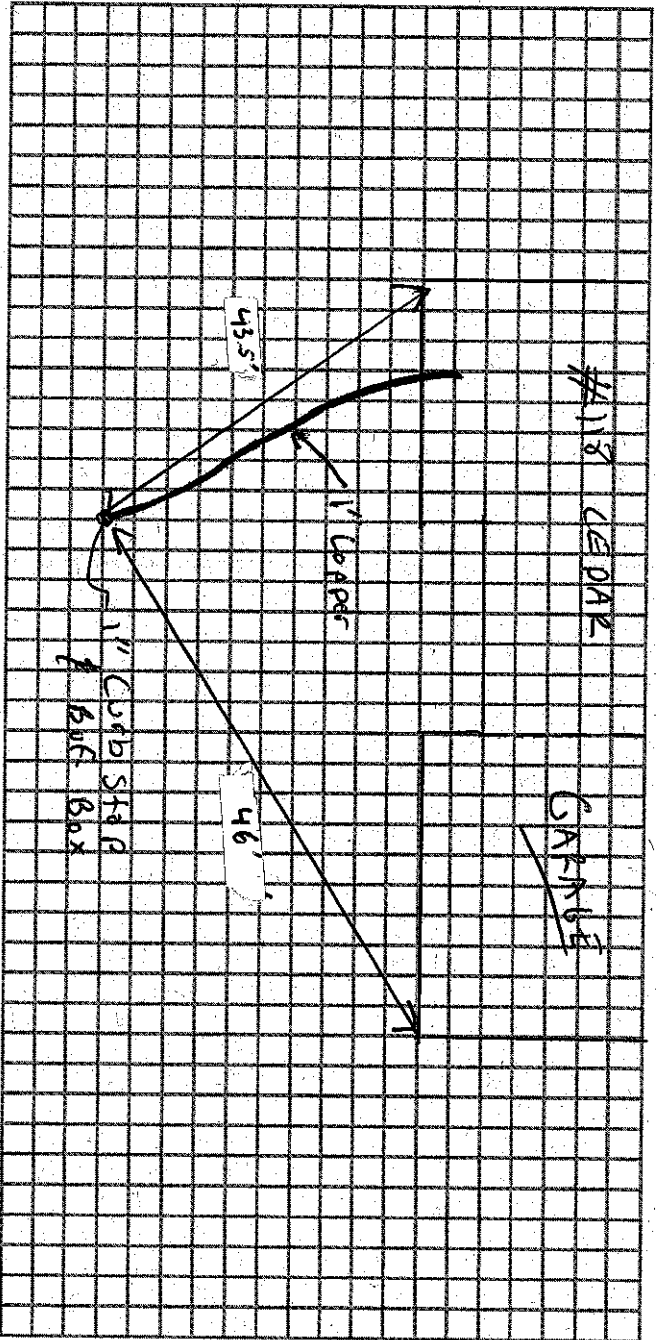

Connection made in: Existing line in CEDAR Street.

Work completed:

Remarks:



Name Kenneth H. Tefft

Service No. ~~30~~ 510

Address Denver Street, Lexington  
118 Cedar St.

# 3413

# 6453

Location 118 Cedar Street, Lexington

Kind of Pipe

Size

Size of Main

Repair—Renewal—New Service

Location

Date	Material	Amount	Total	Date	Amount
1938 June 10	2 hrs @ 60¢	1 20	1 20	June 9, 1938	30 00
<del>July 17-38</del>	29' 3/4" Copper Tuving	5 20	5 80	July 10, 1938	7 06
	1 3/4" S. & W.		3 75		<u>22 94</u>
	1 3/4" Bushing		30		
	Trucking- 2 hrs. @ 75¢		1 50		
			<u>12 55</u>		
	Flat Rate: 29' @ 50¢	14 50			
	Trench Repairs	8 44	\$ 22 94		
	Labor				

Hadley Press, Inc., Lexington

DATE \_\_\_\_\_

# TOWN OF LEXINGTON—BOARD OF PUBLIC WORKS

## WATER DIVISION

The undersigned applies for a supply of water at No. 118 Cedar St St. and hereby agrees to comply with the rules and regulations as now, or at any future time, established by the Board of Selectmen.

Am't. of Estimate \$ 30.-- (Incl. Patching)


Owner Kenneth H. Jeff

Am't. Paid \$ \_\_\_\_\_

Address Albion St  
Lexington,

Builder P.A. Jones Owner digging trench.

Sketch of Service Here

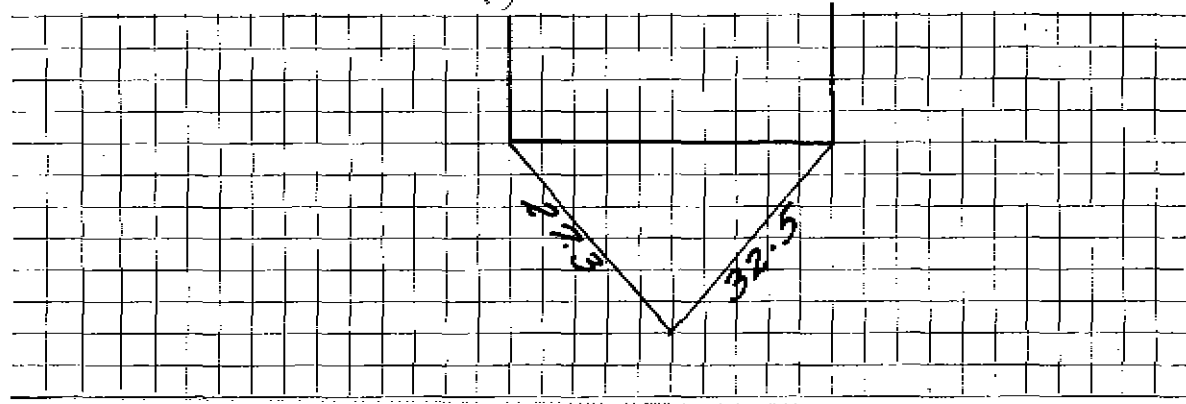

$\frac{3450}{1500}$

Connection made in \_\_\_\_\_ Street.

Work completed \_\_\_\_\_ 19

Remarks: