

WATER SERVICE RECORD

Name Lee E. Tarbox

Service No. 122

Address 12 Cedar Street

Location

Repair - General - New Service W.O. #9326

FEB 15 1965


Date	Material	Amount	Total	Date	Amount
11-3-64	Labor	48 45		10-23-64	Deposit 125 00
	10% O.H.	4 85	53 30	2-15-64	Refund 18 50
35'	3/4" Copper tubing @ .42		14 70		106 80
1	3/4" x 1/2" Compressor Valve		9 29		
	17 x 3 Patch		17 00		CURB TO MAIN
1	3/4"- 3 Part Union		3 01	24'	3/4" Copper tubing @ .42 10 08
1	Hr. Town Shovel		6 50	1	3/4" Adapter 2 76
1	Hr. Town Truck		3 00	1	3/4" Curb Cock 8 76
			106 80	1	Box & Rod 4 90
				1	1/2" Offset 50
				1	1/2" Strait-tailpiece 50
				1	Hr. Town Shovel 6 50
				1	Hr. Town Truck 3 00
					37 00

DATE \_\_\_\_\_

TOWN OF LEXINGTON — BOARD OF PUBLIC WORKS

**WATER DIVISION**

Sketch of Service Here

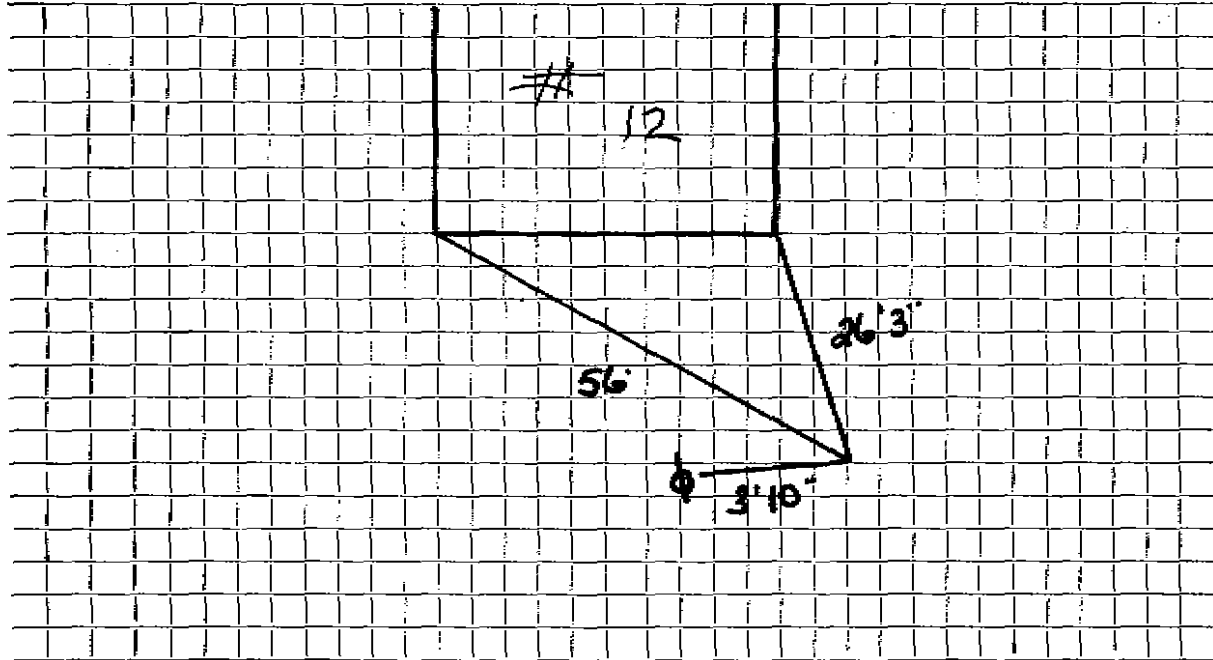

Connection made in ..... Street. Work completed .....

Remarks: .....  
.....  
.....