

Name John F. McCullough

Service No. 127

Address 121 Cedar Street

#5276

Lexington, Mass.

Location 121 Cedar Street

Kind of Pipe

Size

Size of Main

~~Repair~~ ~~Renewal~~ New Service

Location

Date	Material	Amount	Total	Date	Location	Amount
Aug. 18, '48	Labor	3 33	3 33	Aug 14 '48	Deposited	35 00
19	Labor	17 00	17 00	Nov. 5 '48	paid	20 24
20	Labor	3 00	3 00		Non-Charge	55 24
	10% Overhead		2 34	Aug. 20, '48	Labor	14 33
	70'-3/4" Copper Tubing		17 85		9'-3/4" Copper Tubing	2 30
	1-3/4" C x 1/2" I.W.H. S & W		3 15		1-3/4" C. Corp. Cock	3 00
	1-3/4" C x 3/4" C. Union (3 Fts)		1 32		1-3/4" C x 3/4" C. Curb Cock	3 68
	2 hrs. Compressor		3 50		1-Box & Rod	3 55
	1 hr. Trucking		75		4 hrs. Compressor	7 00
	Patching 3 x 3		3 00		1-1/2" Offset Tail Piece	30
			55 24		1-1/2" Straight Tail Piece	30
					1 hr. Trucking	75
						35 21

Bill sent 10/25/48

Labor

part of trench dug by owner then hit ledge

DATE _____

TOWN OF LEXINGTON—BOARD OF PUBLIC WORKS

WATER DIVISION

The undersigned applies for a supply of water at No. _____ St. and hereby agrees to comply with the rules and regulations as now, or at any future time, established by the Board of Selectmen.

Am't. of Estimate \$ _____


Owner _____

Am't. Paid \$ _____

Address _____

Builder _____

Sketch of Service Here

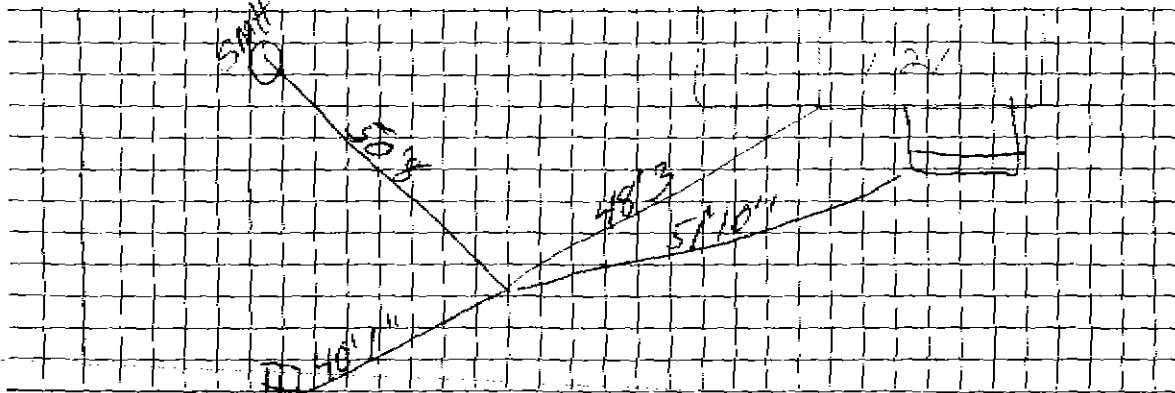

Connection made in _____ Street. Work completed _____ 19

Remarks: