

WATER SERVICE RECORD

Name C. Courtney Comeau

Service No. 93

Address 122 Cedar Street

Location

~~Repair - Repair~~ New Service DeFlice Brothers Permit #481 W.O. #920

OCT 25 1965


Date		Material	Amount		Total		Date	Amount	
9-22-65		Labor	10	18			9-8-65	Deposit	50 00
		10% O.H.	1	02	11	20	10-5-65	Retund	5 31
	26'	3/4" Copper tubing @.42			10	92			44 69
	1	Corporation			7	41			
	1	Curb			8	76			
	1	Box & Road			4	90			
	1/2	Hr. Town Truck @ 3.00			1	50			
					44	69			
11/22/66	36'	3/4" Copper tubing							

DATE \_\_\_\_\_

TOWN OF LEXINGTON — BOARD OF PUBLIC WORKS

WATER DIVISION

Sketch of Service Here

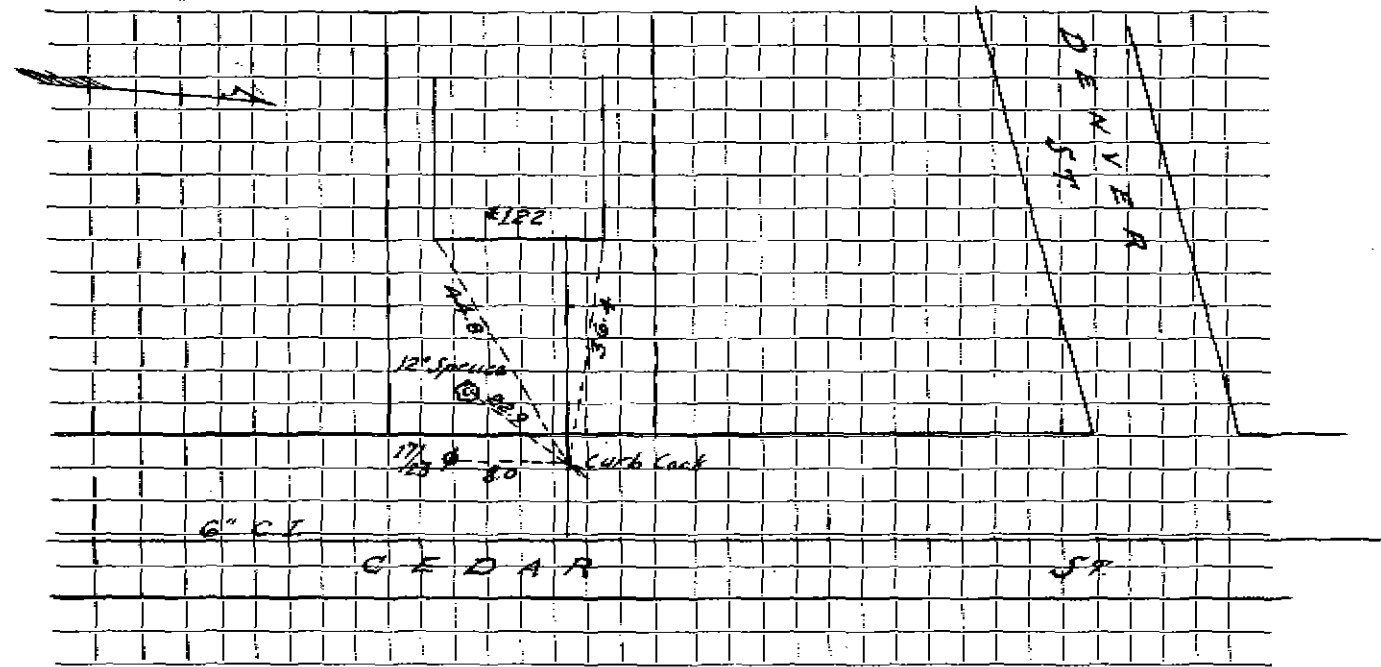

Connection made in ..... Street. Work completed .....

Remarks: .....  
.....  
.....