

WATER SERVICE RECORD

Name David Govan

Service No.

#1663

21

Address 129 Cedar Street

Location Lexington, Mass.

~~XXXXXX~~ New Service


Com. 5-21-51

Date	Material	Amount	Total	Date	Material	Amount
3/10/51	Labor	6 00	6 00	Feb 24 '51	Painted	45 00
	10% overhead		60	Mar 30 '51	Stud	9 97
	75' 3/4" copper tubing @ .36	27 00			No Charge	34 07
	1 - 3/4" C x 1/2 I.W.H.S&W	4 00		3/10/51	labor	7 00
	1 - 3/4" C x 3/4" union (3pts.)	1 72			12' - 3/4" copper tubing @ .36	4 32
	2 hrs. Littlefield shovel	14 00			1 - 3/4" c. corp-cock	4 33
	1 hr. trucking		75		1 - 3/4" C x 3/4" curb-cock	4 67
			54 07		1 - box and rod	4 68
					1 - 1/2 offset tail piece	50
					1 - 1/2 straight tail piece	50
					1 hr. Littlefield shovel	7 00
					1 hr. trucking	75
						33 75

DATE _____

TOWN OF LEXINGTON — BOARD OF PUBLIC WORKS
WATER DIVISION

Sketch of Service Here

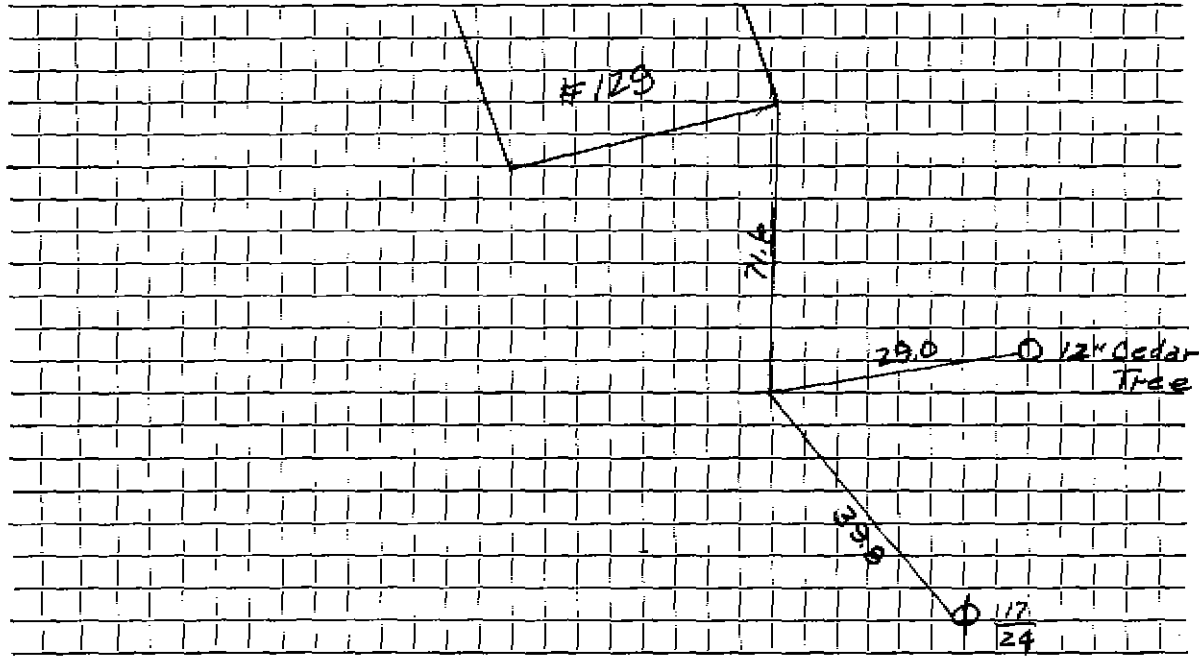

Connection made in Street. Work completed

Remarks:
.....
.....