

77'
Owner do etc. + bhf.

DATE Sept. 14, 1932

TOWN OF LEXINGTON—BOARD OF PUBLIC WORKS

WATER DIVISION

The undersigned applies for a supply of water at No. ¹³⁵ Cedar St. and hereby agrees to comply with the rules and regulations as now, or at any future time, established by the Board of Selectmen.

Am't. of Estimate \$ 57 ⁷⁵

Owner William F. McCabe


Am't. Paid \$ 57 ⁷⁵ 9/14/32

Address 15 Grant St.

Lexington, Mass

Builder _____

Sketch of Service Here

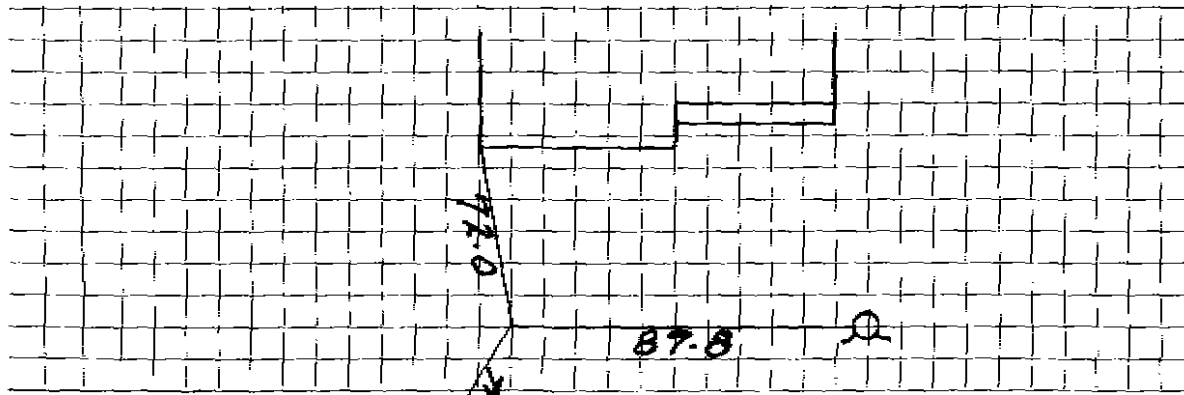

Connection made in _____ Street.

Work completed _____ 19

Remarks: