

WATER SERVICE RECORD

Name

Service No.

Address

136 ~~Wood St~~ Cedar St.

Location


Repair—Renewal—New Service

Date	Material	Amount	Total	Date	Amount
1-15-97	42' 3/4" Copper				
				1-14-97	
					20' 3/4" Copper
					1-3/4 Corp. Adaptor
					1-3/4 Curb.
					1- Box

DATE _____

TOWN OF LEXINGTON — BOARD OF PUBLIC WORKS
WATER DIVISION

Sketch of Service Here

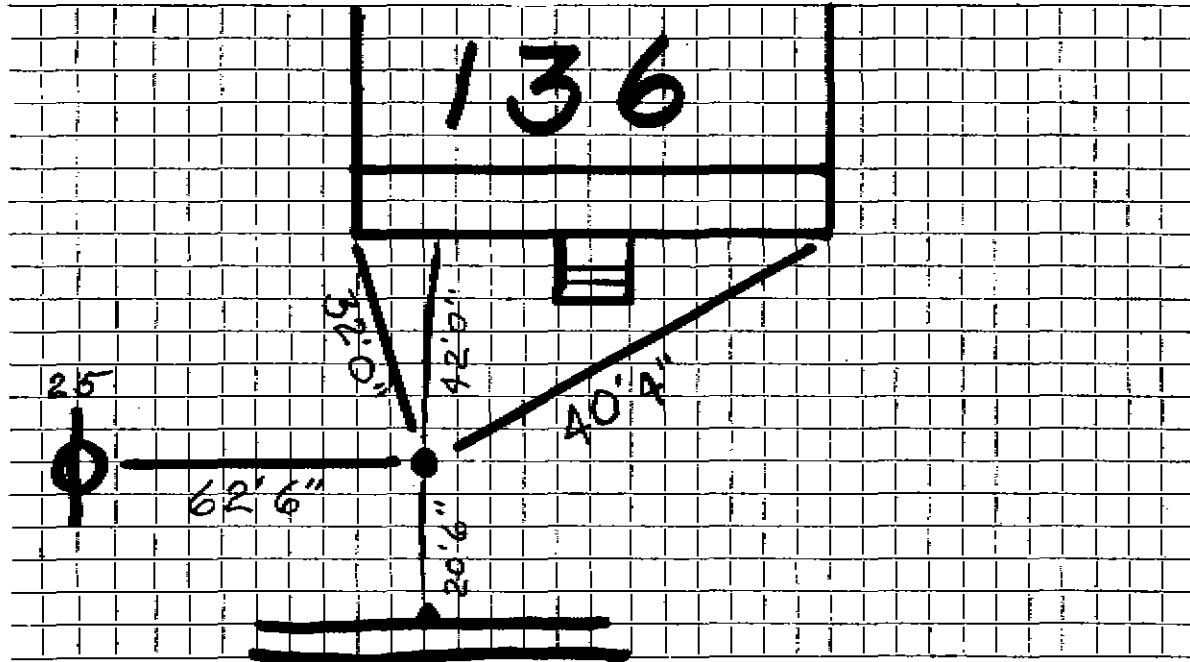

Connection made in Street. Work completed

Remarks:

.....

.....