

WATER SERVICE RECORD

Name

Service No.

Address 140 Cedar ST

Location


Repair Renewal New Service ARLEX

Date	Material	Amount	Total	Date	Material	Amount
	Inside				Outside	
8/10/00	1" Cl. Pipe	31'		12-9-92	18'-3/4 Copper	
	1" COPPER				1-3/4 Comp Corp Adp.	
	1" FX 1" Comp				1-3/4 Comp Curb Stop	
	Bufflo box				1 Cop-Iron Adp.	
					1 Box + Rod	

DATE 12-10-92

TOWN OF LEXINGTON — BOARD OF PUBLIC WORKS
WATER DIVISION

Sketch of Service Here

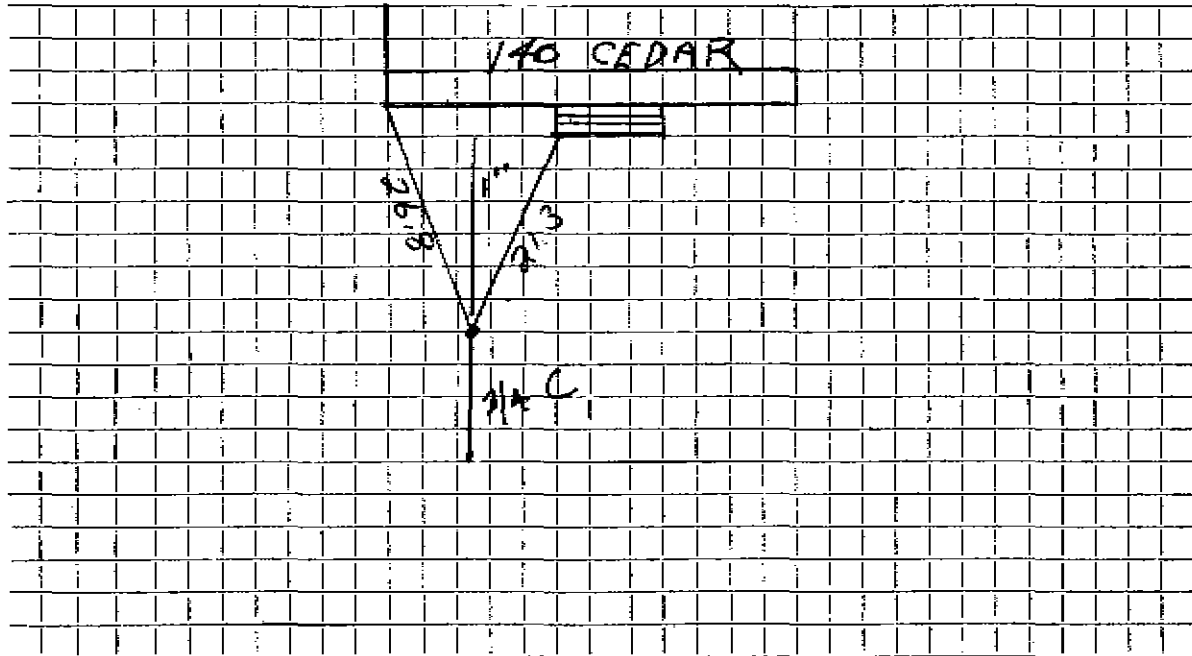

Connection made in 12-8-92..... Street. Work completed

Remarks:

.....

.....