


DATE _____

TOWN OF LEXINGTON — BOARD OF PUBLIC WORKS
WATER DIVISION

Sketch of Service Here

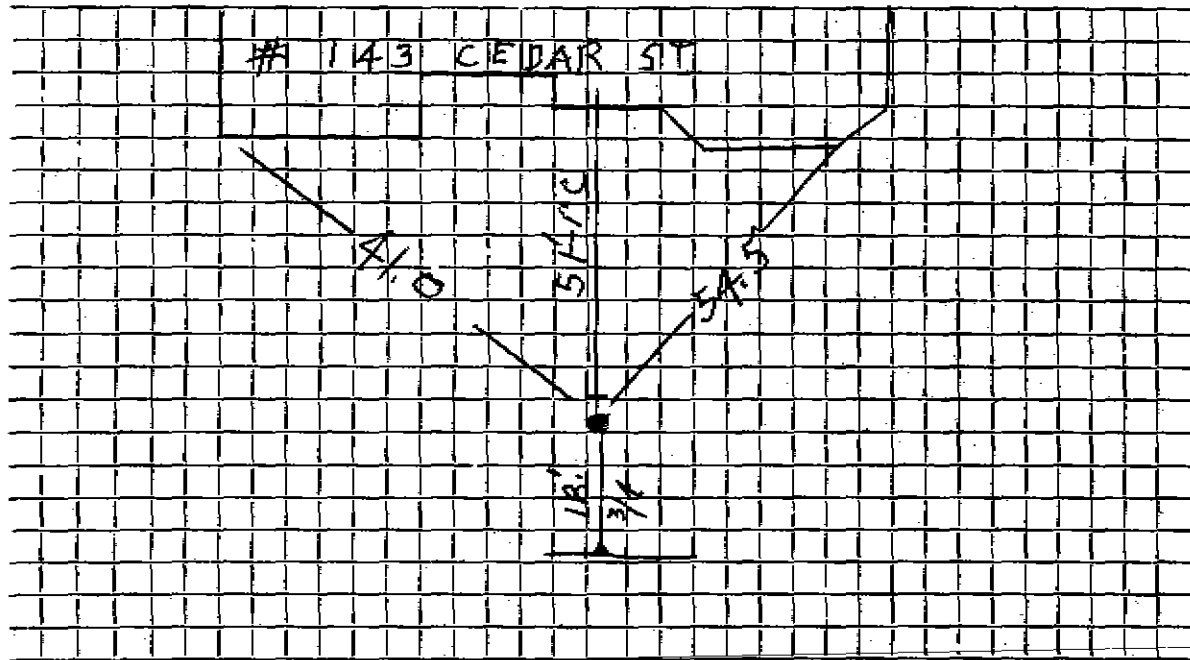

Connection made in _____ Street.

Work completed 12/4/06 Redmond.....

Remarks:

.....

.....