

WATER SERVICE RECORD

Name Louis F. Portais

Service No. 75

#147

Address 147 Cedar Street

Location Lexington, Mass.

~~Removal of Sewer~~ - New Service


Com. 8-6-51

Date	Material	Amount	Total	Date	Amount
5/1/51	Labor	5 99	5 99	4/30/51	50 00
	10% overhead		60	5/1/51	64 00
	45' 3/4" copper tubing @.326	14 67			118 00
	1 -3/4" C x 1/2 I.W.H.stop & waste	4 00			
	2 hrs. Littlefield shovel@7.00	14 00		5/1/51	6 00
	1 hr. trucking patching 5 x 3	5 00		15' 3/4" copper tubing @ .326	4 89
		45 01		1 - 3/4" C. corp-cock	4 33
				1 - 3/4" C x 3/4" curb-cock	4 67
				1 - box and rod	4 68
				1 - 1/2 offset tail piece	50
				1 - 1/2 straight tail piece	50
				1 hr. Littlefield shovel	7 00
				1 hr. trucking	75
					33 32

DATE _____

TOWN OF LEXINGTON — BOARD OF PUBLIC WORKS
WATER DIVISION

Sketch of Service Here

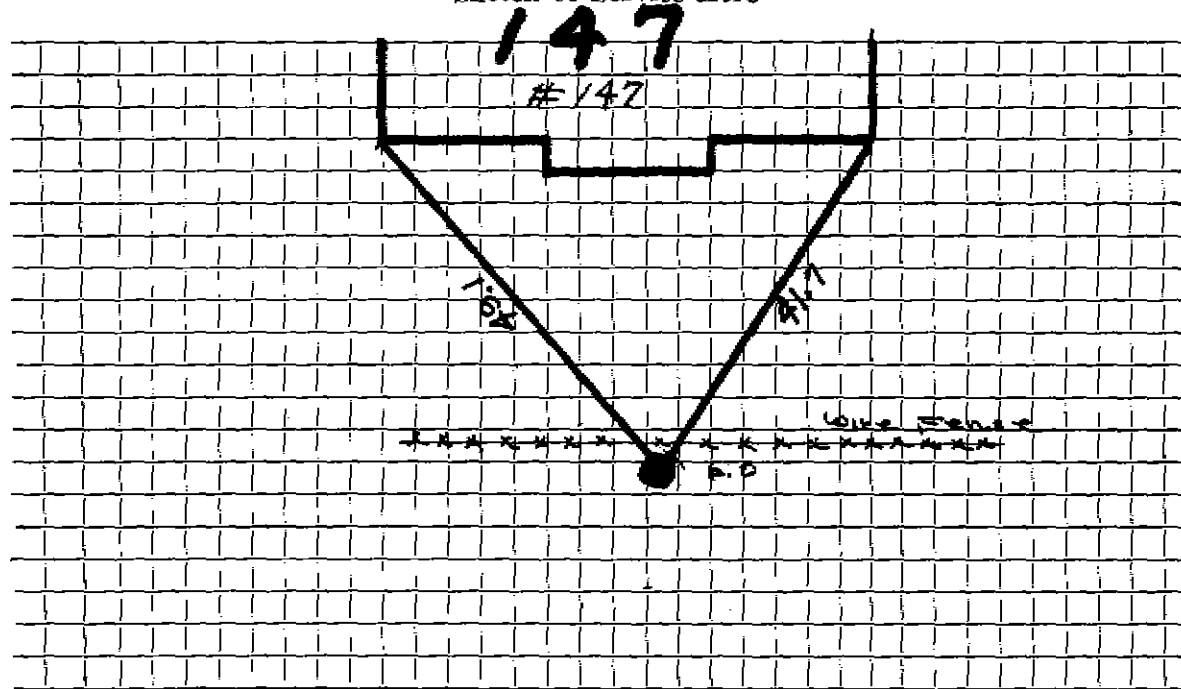

Connection made in Street. Work completed

Remarks:
.....
.....