

Name Henry Kirkland
 Address 148 Cedar Street
 Lexington, Mass.

2038
 Service No.

262

Location

Kind of Pipe

Size

Size of Main

~~Repair & Renewal~~ - New Service

Location

Date	Material	Amount	Total	Date	Amount
Nov. 11, '48	Labor	1 25	1 25		
	10% Overhead		13		
	38'-3/4" Copper Tubing @ .255	9 69			
	1-3/4" C x 1/2" I.W.H. ^{DOOW}	3 15			
	1-3/4" C x 3/4" C. Union (3pts)	1 32			
	1 hr. Trucking		75		
	Patching 12 x 3		12 00		
			28 29		
	trench dug by owner.				
	Labor				
				Oct. 29 '48	50 00
				Dec. 31 '48	1 75
					28 29
				Nov. 1, '48	30 16
				18'-3/4" Copper Tubing @ .255	4 59
				1-3/4" C. Corp-cock	3 00
				1-3/4" C x 3/4" C. Curb-cock	3 68
				1-Box & Rod	3 55
				1-1/2" Offset Tail Piece	30
				1-1/2" Straight Tail Piece	30
				1 hr. Trucking	75
					46 33

TOWN OF LEXINGTON - BOARD OF PUBLIC WORKS

WATER DIVISION

The undersigned applies for a supply of water at No..... St. and hereby agrees to comply with the rules and regulations as now, or at any future time, established by the Board of Selectmen.

Am't of Estimate \$.....

Owner


Am't Paid \$.....

Address

Builder

.....

Sketch of Service Here

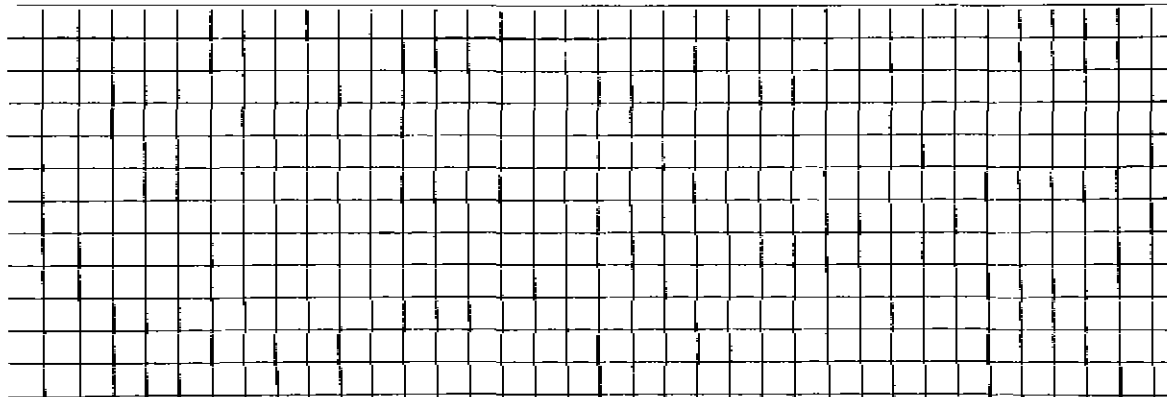

Connection made in Street.

Work completed19

Remarks: