

Name John E. Penney
 Address 153 Cedar Street
 Lexington, Mass.

Service No. 100

Location 153 Cedar Street

1735

Kind of Pipe . Size Size of Main
~~Repair - Renewal~~ - New Service Com. 6-14-49 Location

Date	Material	Amount	Total	Date	Amount
May 11, '49	Labor	4 15	4 15	May 9 '49	50 00
	10% Overhead		42	June 24 '49	6 31
	47' - 3/4" Copper Tubing @.27	12 69			48 69
	1 - 3/4" C x 1/2" I.W.H S&W	3 29		May 11, '49	4 15
	1 - 3/4" C x 3/4" C Union (Bpts)	1 39		17' - 3/4" Copper Tubing @.27	4 59
	Littlefield Shovel 2 hrs. @7.00	14 00		1 - 3/4" C Corp-cock	3 15
	Trucking 1 hr. @.75	75		1 - 3/4" C x 3/4" C Curb-cock	3 85
	Patching 7 x 3		7.00	1 - Box & Rod	3 95
			43 69	1 - 1/2" Offset Tail Piece	37
				1 - 1/2" Straight Tail Piece	37
				Littlefield Shovel 1 hr. @7.00	7 00
				Trucking 1 hr. @.75	75
	Labor				28 18

Deposited
 Funded
 Non-Charge

DATE _____

TOWN OF LEXINGTON - BOARD OF PUBLIC WORKS
WATER DIVISION


The undersigned applies for a supply of water at No..... St. and hereby agrees to comply with the rules and regulations as now, or at any future time, established by the Board of Selectmen.

Am't of Estimate \$..... Owner

Am't Paid \$..... Address

Builder

Sketch of Service Here

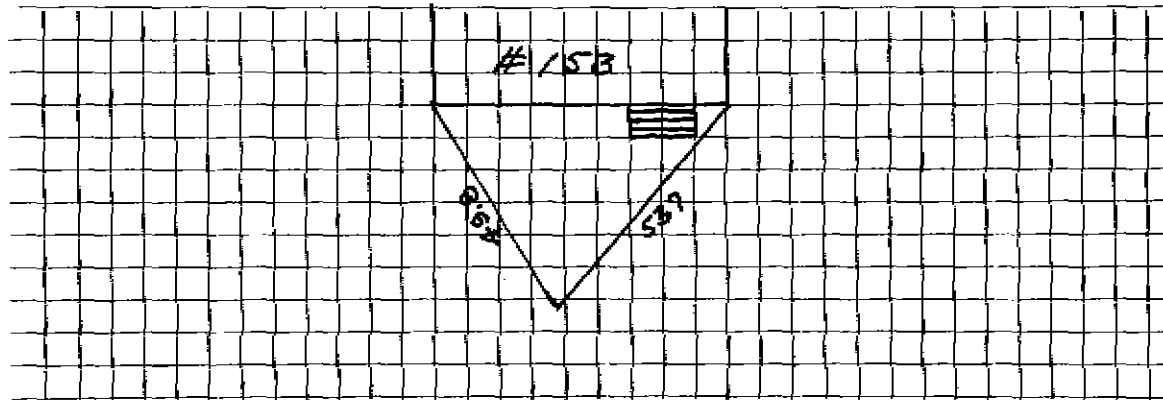

Connection made in Street.

Work completed19

Remarks: