

WATER SERVICE RECORD

Name *John Sirois*

Service No. *51*

Address *154 Cedar St*

Location *WD # 1394*

Repair—Renewal—New Service *DeFlice Bros. # 2363*

FEB 10 1975


Date	Material	Amount	Total	Date	Amount
<i>11-13</i>	<i>73 40' - 3/4" Copper</i>			<i>10-16-73</i>	<i>Deposit 100.00</i>
				<i>2-16-75</i>	<i>Refund 38.38</i>
					<i>71.72</i>
	<i>Labor</i>	<i>\$16.32</i>			
		<i>1.36</i>	<i>\$17.95</i>		
	<i>23' 3/4" Copper tubing @98</i>		<i>22.54</i>		
<i>1</i>	<i>3/4 Corp</i>		<i>9.57</i>		
<i>1</i>	<i>Box and Rod</i>		<i>7.34</i>		
<i>1</i>	<i>hr Trucking</i>		<i>3.00</i>		
		<i>Total</i>	<i>\$71.72</i>		

DATE _____

TOWN OF LEXINGTON — BOARD OF PUBLIC WORKS

WATER DIVISION

Sketch of Service Here

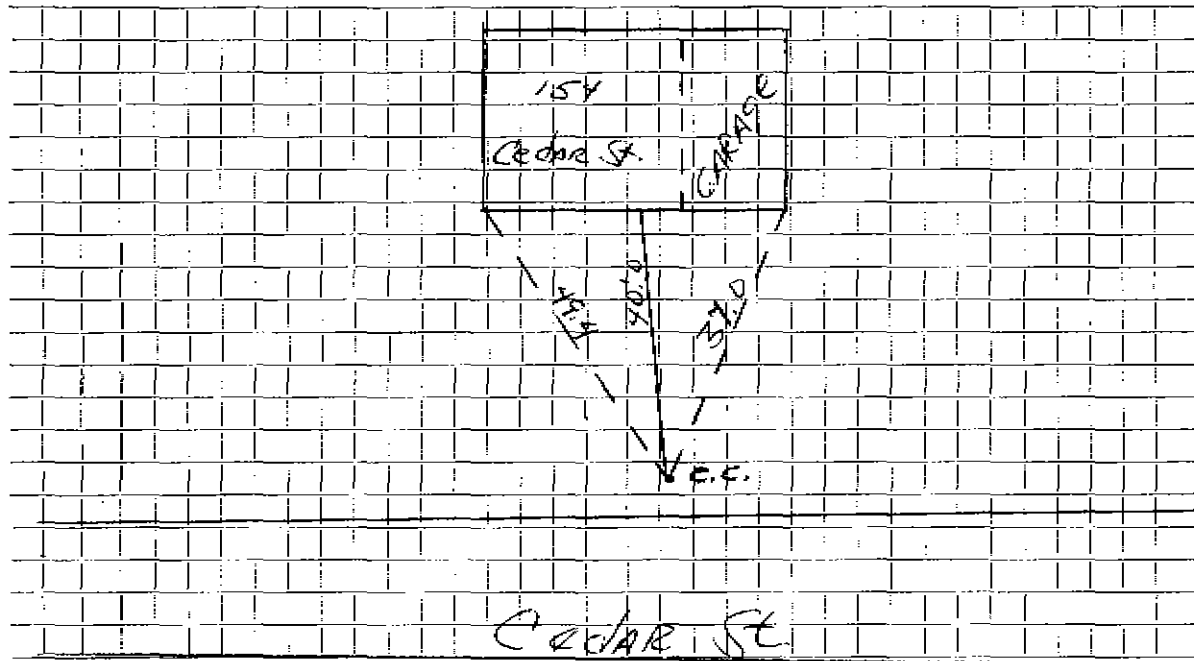

Connection made in _____ Street. Work completed _____

Remarks: _____
