




DATE 12/2018

TOWN OF LEXINGTON — BOARD OF PUBLIC WORKS

WATER DIVISION

Sketch of Service Here

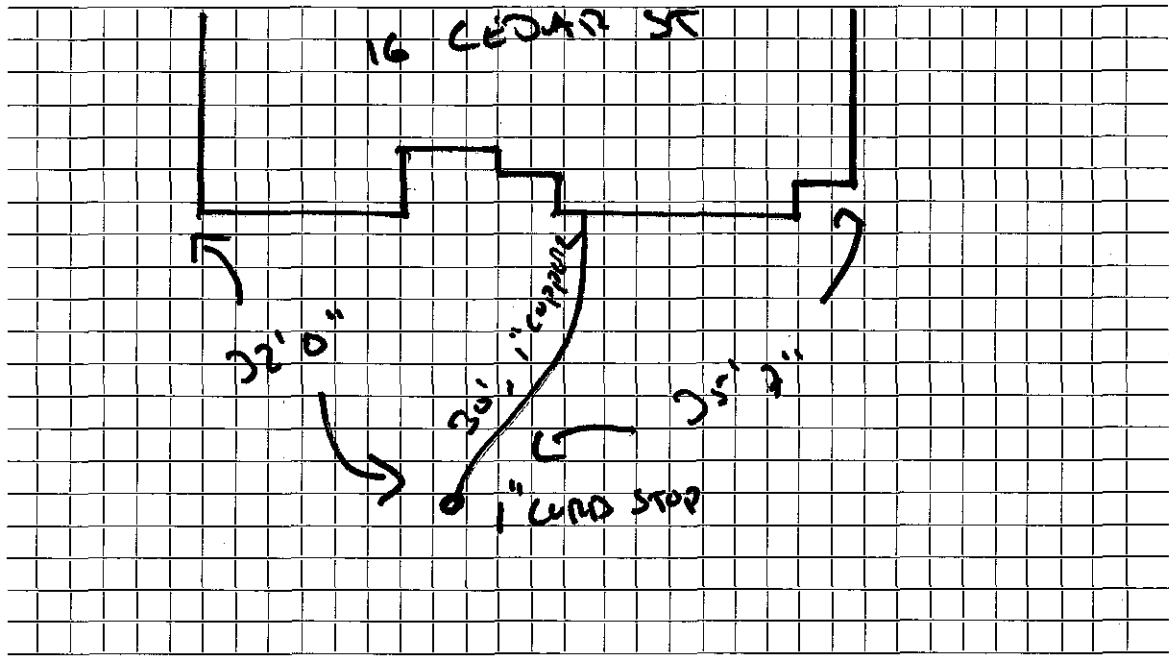

Connection made in ... CEDAR Street. Work completed ... McLaughlin

Remarks: .....

.....

.....