

WATER SERVICE RECORD

2251

Name Mary Oram

Service No. 94

Address 160 Cedar Street

Location

~~Repair~~ ~~Renewal~~ New Service

Comm 8-1-60


Date	Material	Amount	Total	Date		Amount
7-1-60	Labor	1 94		6-10-60	Deposit	75 00
	10% O.H.	19	2 13	8-1-60	Retard	37 30
	60' 3/4" Copper tubing @42		29 40			37 70
	1 3/4" x 1/2" I.N.H. Stop&Waste		6 17			
			37 70		NON CHARGE	
					Labor	1 75
				14'	3/4" Copper tubing @42	5 88
				1	3/4" 3 Comp Cock	4 95
				1	3/4" 3 Surb Cock	6 28
				1	Box & Ho6	5 00
				1	1/2" Straight tailpiece	50
				1	1/2" Offset tailpiece	50
						24 82

DATE _____

TOWN OF LEXINGTON — BOARD OF PUBLIC WORKS

WATER DIVISION

Sketch of Service Here

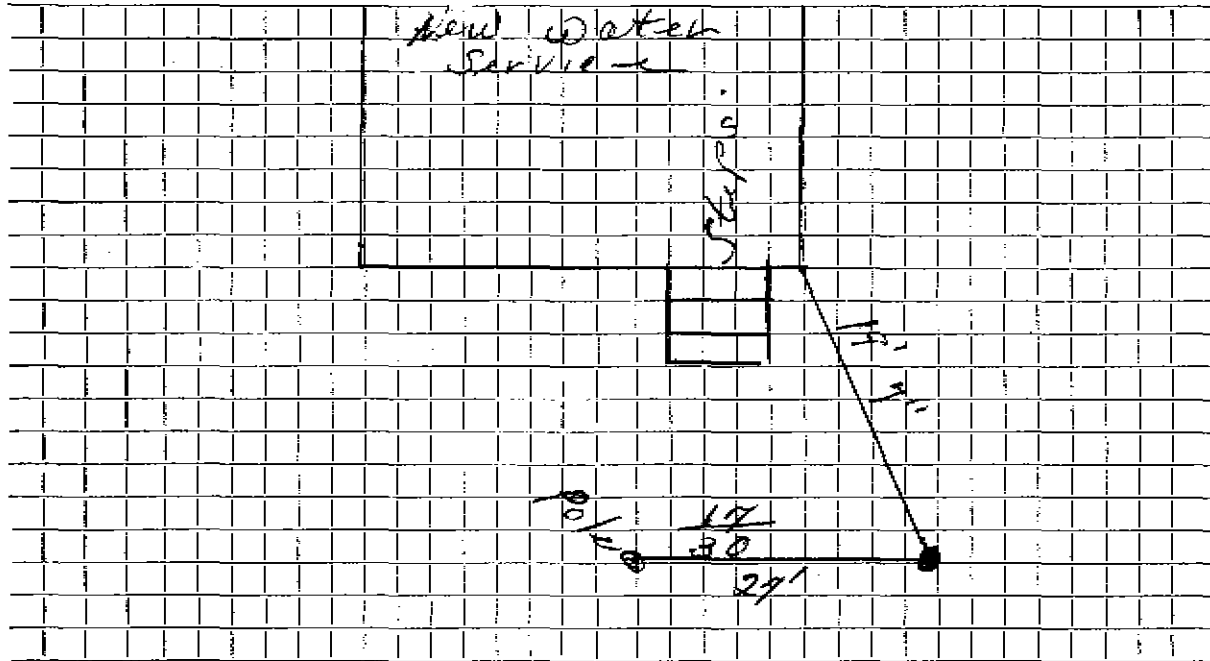

Connection made in Street. Work completed

Remarks:

.....
.....