

WATER SERVICE RECORD

Name F. K. Marcy

Service No. 184

Address 167 Cedar Street

#5267

Location Lexington

Repair ~~Renewal~~ New Service

Com. 9-29-52


Date	Material	Amount	Total	Date	Amount
8/29/52	Labor	4 75		8-23-52 Deposited	100 00
	10% Overhead	48	5 23	9-29-52 Refunded	(5 16
	180' - 1" Copper tubing @ .3997		71 95		NON CHARGE
	1 - 1" C x 1" I.W. H. stop & waste	6 80		9/11/52 Labor	6 04
	2 - 1" C x 1" C. Union 3pts	4 52		18' - 1" copper tubing @ .3997	7 19
	1 - 1" X 3/4" Red. Bushing	59		1 - 1" C. Corp-cock	5 61
	1 hr. trucking		75	1 - 1" C x 1" C. curb-cock	6 80
	patching 5 x 3		5 00	1 box and rod	3 90
			94 84	1 - 3/4" offset tail piece	50
	TRENCH DUG BY OWNER			1 - 3/4" straight tail piece	50
				2 hrs. Littlefield shovel	14 00
				1 hr. trucking	75
					45 29

DATE _____

TOWN OF LEXINGTON — BOARD OF PUBLIC WORKS

WATER DIVISION

Sketch of Service Here

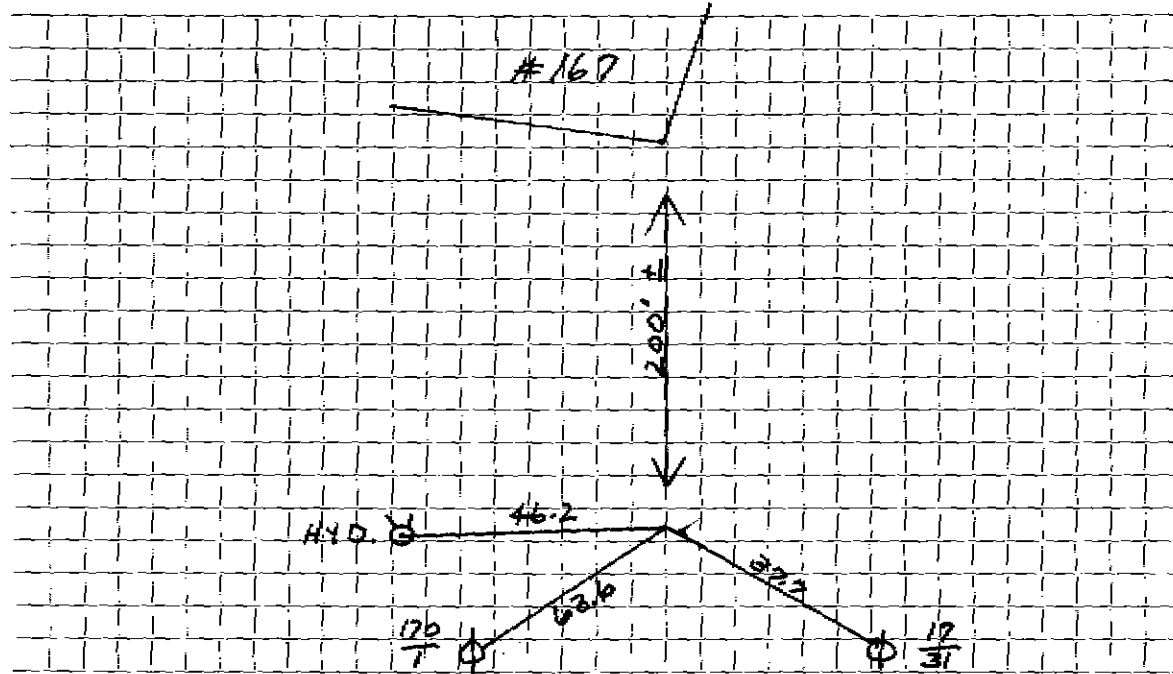

Connection made in Street. Work completed

Remarks:

.....

.....