

Name Edward Cassidy
 Address 173 Cedar Street
 Lexington, Mass.

2823

Service No. 199
 # 7203

Location 173 Cedar Street

Kind of Pipe

Size

Size of Main

~~Repair or Renewal~~ New Service

Com. 9-26-49

Location

Date	Material	Amount	Total	Date	Amount
Sept. 7, '49	Labor	7 25	7 25	Aug 29 '49	60 00
	10% Overhead		73	Oct 1 '49	
	48' - 3/4" Copper Tubing @ .24	11 52	11 52		50 54
	1 - 3/4" C x 1/2" I.W.H. S&W	3 29	3 29	Sept. 7, '49	7 00
	Littlefield Shovel 3 hrs.	21 00	21 00	12' - 3/4" Copper Tubing @ .24	2 88
	Trucking 1 hr. @ .75	75	75	1 - 3/4" C Corp-cock	3 15
	Patching 6 x 3	6 00	6 00	1 - 3/4" C x 3/4" C Curb-cock	3 85
			50 54	1 - Box & Rod	3 75
				1 - 1/2" Offset Tail Piece	37
				1 - 1/2" Straight Tail Piece	37
				Shovel 1 hr. @ 7.00	7 00
				Trucking 1 hr. @ .75	75
	Labor				29 12

Deposited
Refused
 No Charge

DATE _____

TOWN OF LEXINGTON - BOARD OF PUBLIC WORKS

WATER DIVISION

The undersigned applies for a supply of water at No. St. and hereby agrees to comply with the rules and regulations as now, or at any future time, established by the Board of Selectmen.

Am't of Estimate \$.....

Owner


Am't Paid \$.....

Address

Builder

.....

Sketch of Service Here

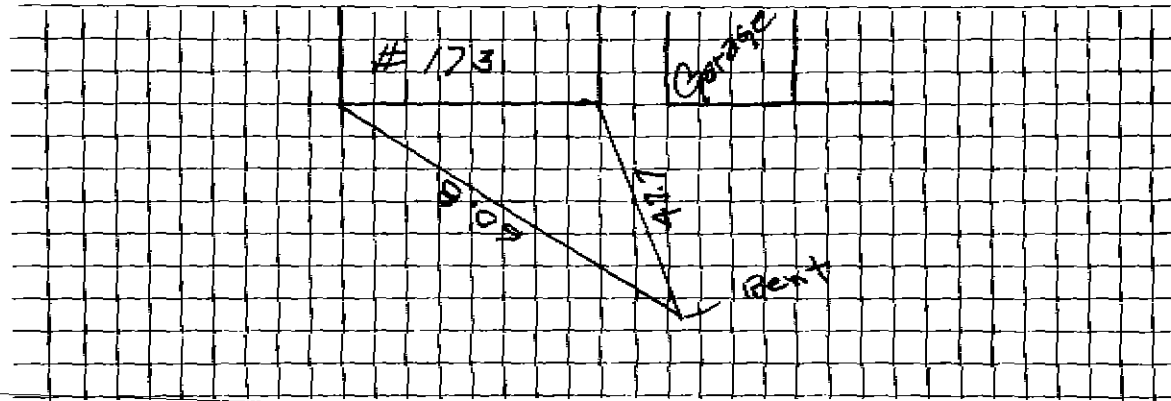

Connection made in Street.

Work completed 19

Remarks: