


TOWN OF LEXINGTON - BOARD OF PUBLIC WORKS
WATER DIVISION

Date: 11/16/2020

SKETCH OF SERVICE HERE

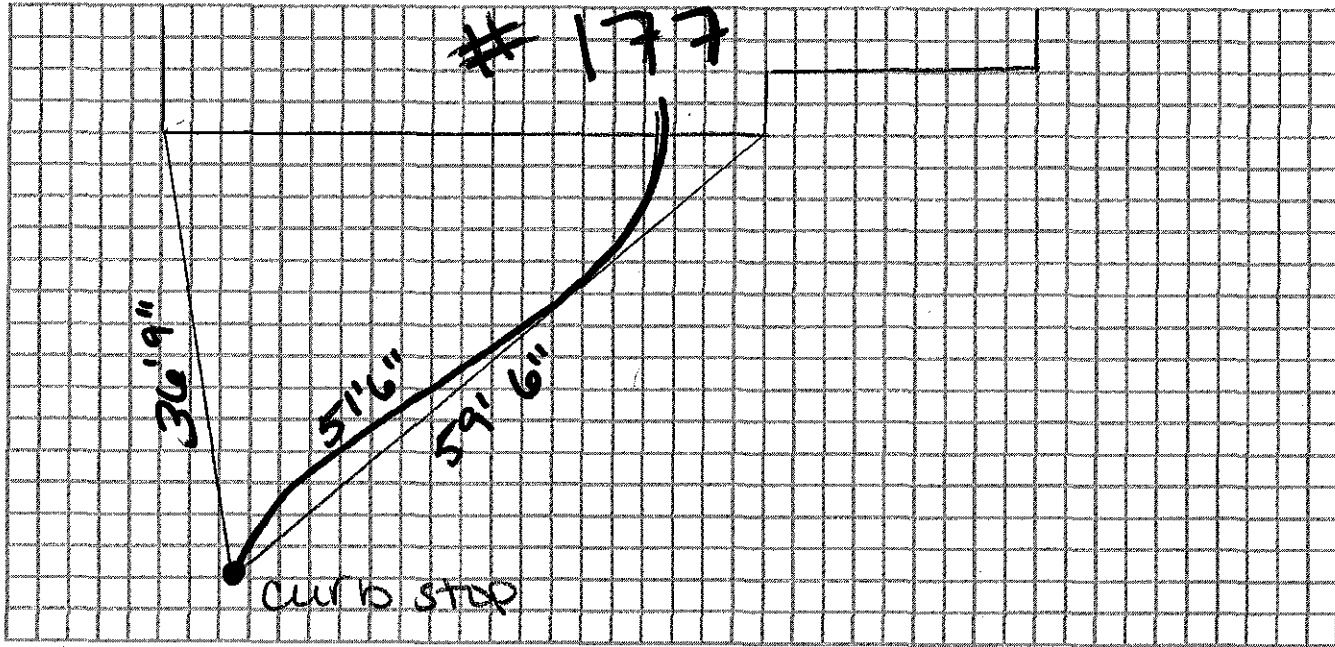

Connection made in: Cedar Street. Work completed:

Remarks:

depth @ curb stop = 4'